



1:100

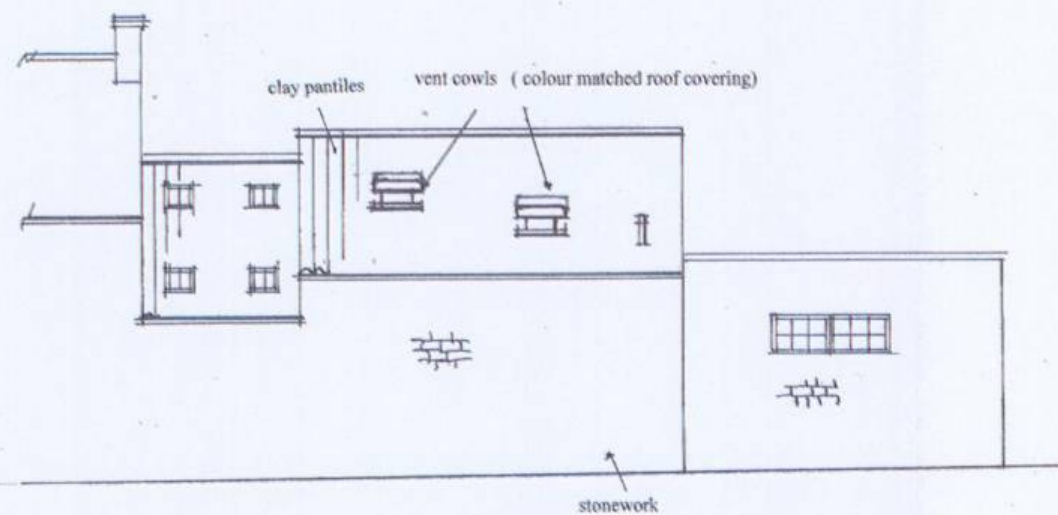

South Elevation

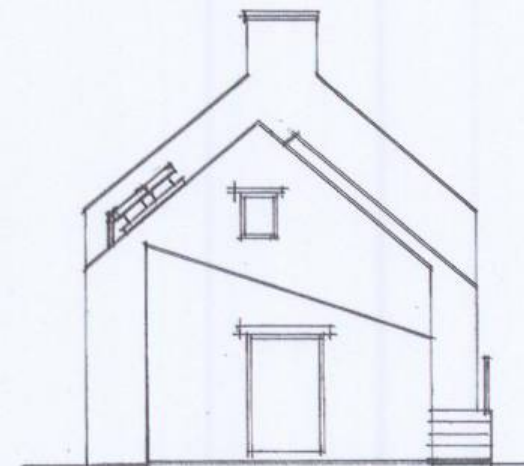

East Elevation

RYEDALE DM


27 AUG 2013

DEVELOPMENT
MANAGEMENT

13/00919/FUL

THIS COPY HAS BEEN MADE BY OR WITH THE
AUTHORITY OF RYEDALE DISTRICT COUNCIL
PURSUANT TO SECTION 87 OF THE COPYRIGHT,
DESIGNS AND PATENTS ACT 1988. UNLESS
THAT ACT PROVIDES A RELEVANT EXCEPTION TO
COPYRIGHT, THE COPY MUST NOT BE COPIED
WITHOUT THE PRIOR PERMISSION OF THE
COPYRIGHT OWNER.

Project: Retention of kitchen extract system cowls
Location: The Plough Inn, Wombledon
Client: Mrs B Marshall
Drg Title: Elevations showing cowls as installed
Drg N.o: PIW/P01
Scale: 1:100
Date: July 2013

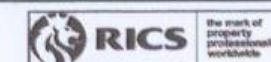

Phil Parker MRICS MIFireE

P M PARKER Surveying and Design Ltd

Low Barn 76 Kingsgate Bridlington East Yorkshire YO15 3PL

Tel: 01262 676610 Mobile: 07531 548905

Email: pm.parker@talktalk.net