



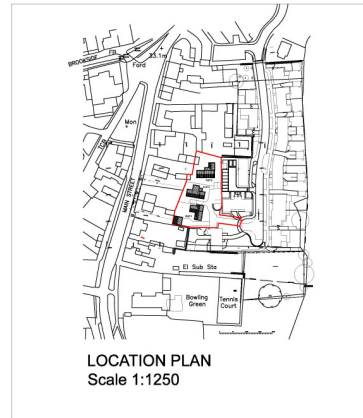

REVISED PLAN

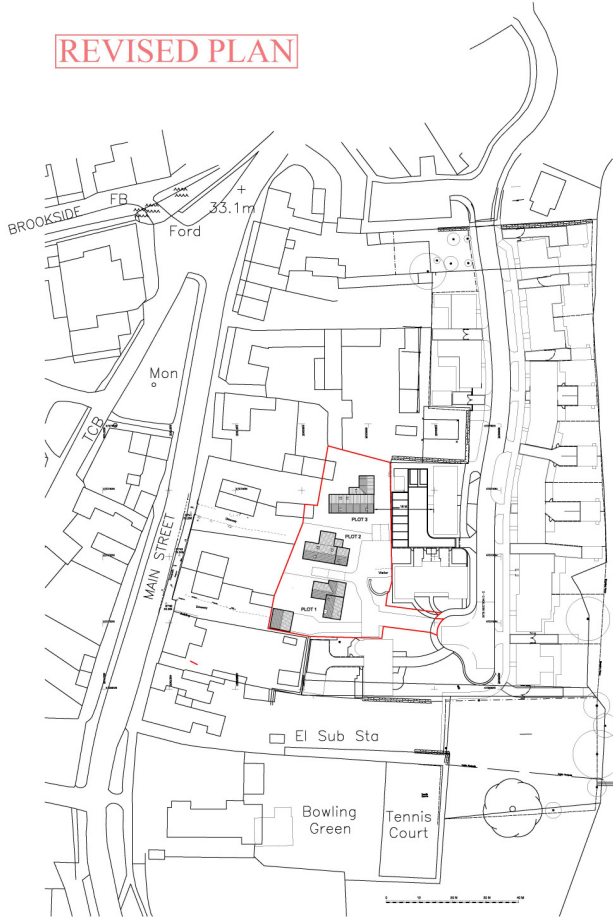

LOCATION PLAN
Scale 1:1250

THIS COPY AND CONTENTS IS NOT VALID FOR CONSTRUCTION OF PROVISIONAL PLANS. ANY CHANGES TO THE PROVISIONAL PLANS MUST BE APPROVED BY THE LOCAL AUTHORITY. ANY CHANGES TO THE PROVISIONAL PLANS MUST BE APPROVED BY THE LOCAL AUTHORITY.

- Rev E 07.01.16 Minor amendments to Plots 2 & 3
- Rev d 27.11.15 Minor amendments
- Rev c 19.11.15 Minor amendments
- Rev b 02.11.15 Minor amendments
- Rev a 29.10.15 Boundary amended

RIBA #



BrierleyGroom
Architects

BrierleyGroom LLP
 17th Floor, The Leazes, Newcastle
 Newcastle Business Park, Sea, NE20 9JQ
 0191 2610000
 www.brierleygroom.co.uk
 info@brierleygroom.co.uk

client	
HOVINGHAM ESTATE	
project	
RESIDENTIAL DEVELOPMENT LAND WEST OF PASTURE LANE, HOVINGHAM	
drawing	
BLOCK PLAN & LOCATION PLAN	
date	stage
OCT. 2015	PLANNING
scale	revision
1:500 @ A1	E
number	DATE
H117.01.300	18/01/16



REVISED PLAN

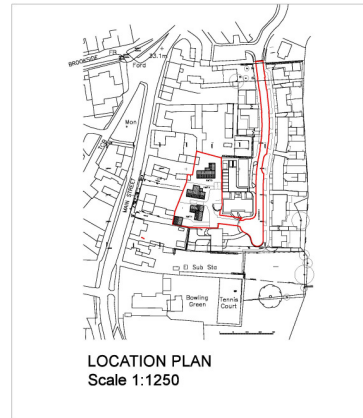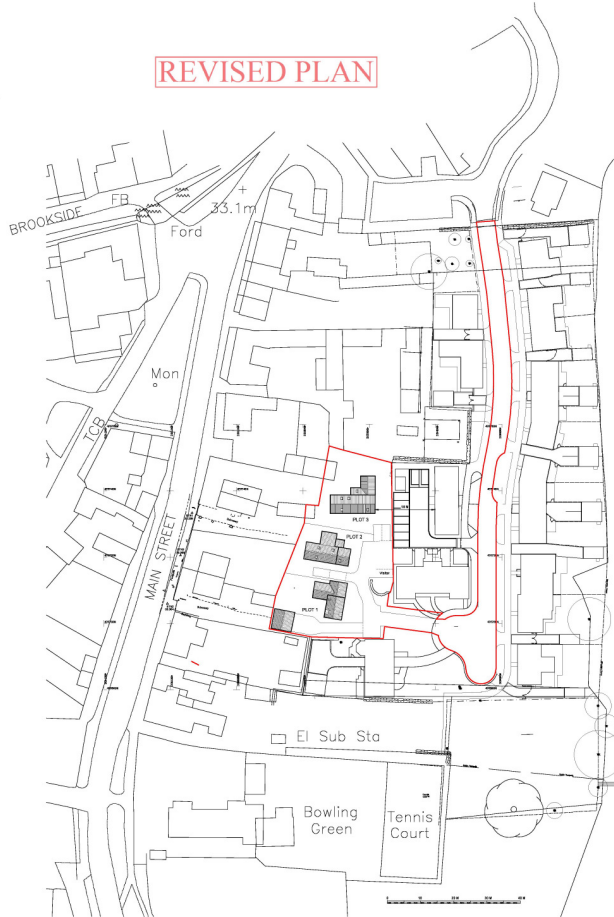

THIS PLAN IS A PRELIMINARY DESIGN AND IS NOT TO BE USED FOR CONSTRUCTION OR AS A BASIS FOR ANY OTHER DESIGN OR CONTRACT. ANY CHANGES TO THIS PLAN MUST BE APPROVED BY THE ARCHITECT.

- Rev F 12.01.16 Red line app site amended.
- Rev E 07.01.16 Minor amendments to Plots 2 & 3
- Rev d 17.11.15 Minor amendments
- Rev c 10.11.15 Minor amendments
- Rev b 02.11.15 Minor amendments
- Rev a 29.10.15 Boundary amended

RIBA #

BrierleyGroom
Architects

Brierley Groom LLP
 27-29, The Arcade, Newcastle Road,
 Northampton Business Park, Unit 100, NN2 6JG,
 Northampton NN1 6JG
 t 01603 761761
 e info@brierleygroom.co.uk
 www.brierleygroom.co.uk

client	
HOVINGHAM ESTATE	
project	
RESIDENTIAL DEVELOPMENT LAND WEST OF PASTURE LANE, HOVINGHAM	
drawing	
BLOCK PLAN & LOCATION PLAN	
date	series
OCT. 2015	PLANNING
scale	revision
1:500 @ A1	F
DATE	NUMBER
18/01/16	H117.01.300