


NOTES
 1. This document is the property of RICS and is to be used only for the purposes for which it is issued. It is not to be used for any other purpose without the prior written consent of RICS.
 2. This document is not to be used as a basis for any legal proceedings.
 3. This document is not to be used as a basis for any insurance claim.
 4. This document is not to be used as a basis for any other claim.
 5. This document is not to be used as a basis for any other action.
 6. This document is not to be used as a basis for any other purpose.
 7. This document is not to be used as a basis for any other action.
 8. This document is not to be used as a basis for any other purpose.
 9. This document is not to be used as a basis for any other action.
 10. This document is not to be used as a basis for any other purpose.

REVISIONS
 No. Date / Description of Change



--- ASSUMED LOCATION OF WATER PIPE BASED ON INVESTIGATIONS
 ——— SAFER/AS-BUILT LOCATION OF WATER PIPE

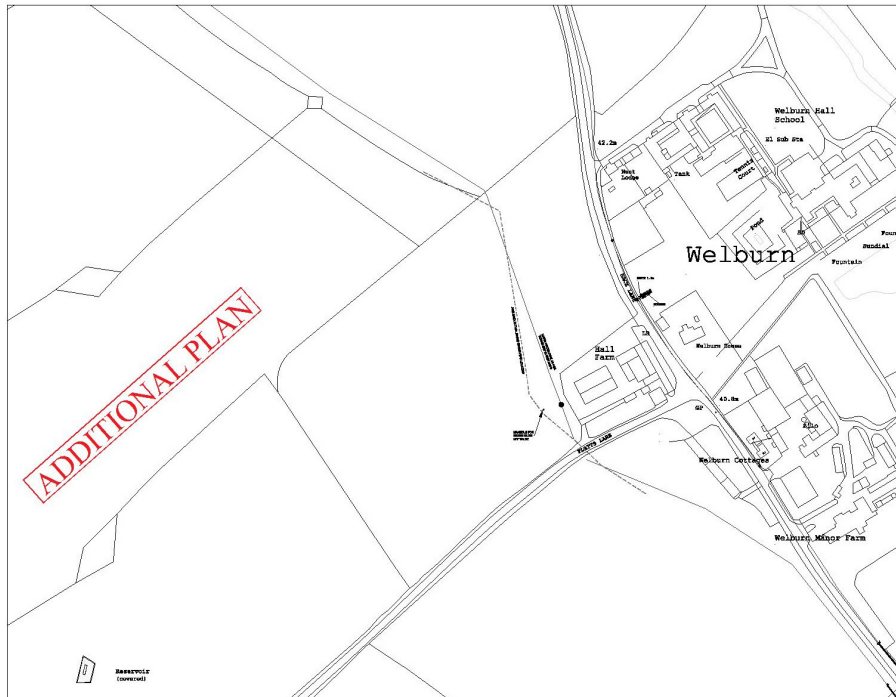

PROJECT TITLE
 WELBURN HALL FARM
 BACK LANE
 WELBURN YO22 7RH
CLIENT
 MRS WILLEMAN SHAW

PROJECT INFO
 EXISTING WATER PIPE LOCATION PLAN
PROJECT NO 111250 **PROJECT / AREA / SITE NO** YSRU 383224/AG105

PREPARED BY PJB **CHECKED BY** PJB **DATE** APRIL 17 2017

DATE
 24.04.17



NOTES
 1. This document is the property of RICS and is to be used only for the purposes for which it is issued. It is not to be used for any other purpose without the prior written consent of RICS. RICS does not accept any liability for any loss or damage arising from the use of this document for any purpose other than that for which it is issued. RICS is not responsible for any loss or damage arising from the use of this document for any purpose other than that for which it is issued. RICS is not responsible for any loss or damage arising from the use of this document for any purpose other than that for which it is issued.

REVISIONS
 No. / Date / Description of Change



- ABSUMED LOCATION OF WATER PIPE BASED ON INVESTIGATIONS
- SAFERMOVE EXISTING LOCATION OF WATER PIPE
- PROPOSED NEW LOCATION OF WATER PIPE



PROPOSED WATER PIPE LOCATION PLAN
 BACK LANE
 WELBURN YO62 7YH
 RICS WILLIAM SHAW

PROPOSED WATER PIPE LOCATION PLAN
 SCALE 1:1250
 PROJECT / DRAWING NO. YSRU 38324/ND06
 INFORMATION
 DRAWN BY PJS CHECKED BY PJS DATE APRIL 17 2017

DATE
 24.04.17

