


WEST ELEVATION

EAST ELEVATION

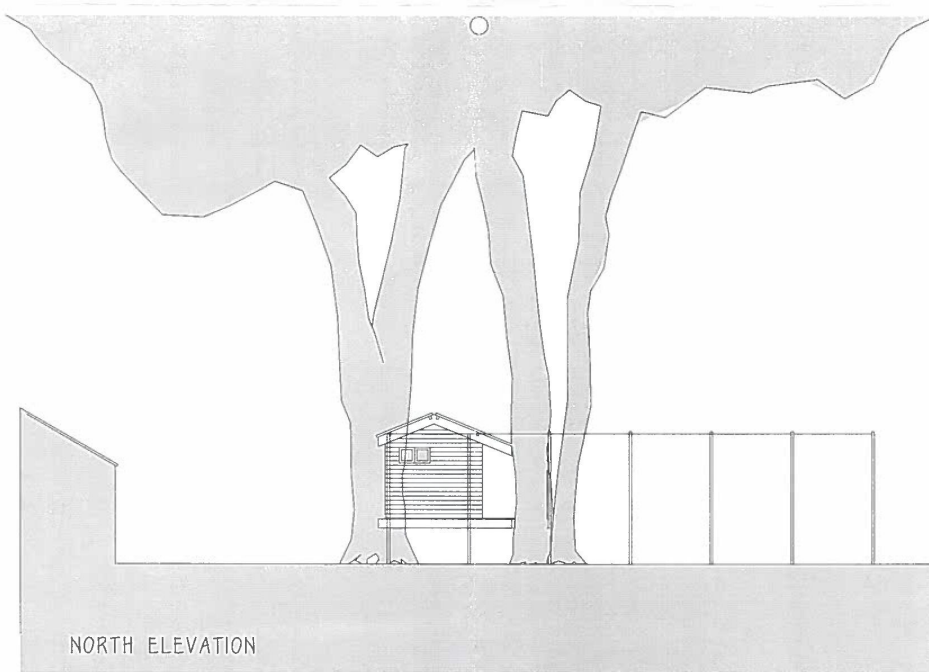

NORTH ELEVATION

RETROSPECTIVE APPLICATION FOR TREE HOUSE IN THE GARDEN OF  
 MANOR FARM, EAST LUTTON, MALTON YO17 8TG  
 FOR MR & MRS ANDREW THORNTON  
 DRAWING 02 A AS BUILT DETAILS with proposed additional trellis work to deck  
 SCALE 1:100 @A3 oct 17  
 David Ward Architectural davidward589@btinternet.com 01751 476 865