


Ground Floor

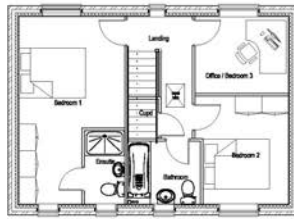

First Floor

Scale Bar: -
 5m 1:100

THIS COPY HAD BEEN MADE BY OR WITH THE AUTHORITY OF RYEDALE DISTRICT COUNCIL PURSUANT TO SECTION 47 OF THE COPYRIGHT DESIGNS AND PATENTS ACT 1988. UNLESS THAT ACT PROVIDES A RELEVANT EXCEPTION TO COPYRIGHT, THE COPY MUST NOT BE COPIED WITHOUT THE PRIOR PERMISSION OF THE COPYRIGHT OWNER.

Revisions


Development
**Firlands Road
 Pickering
 Phase 2**

Drawing Title
**The Clayton Housetype
 Planning Drawing
 As Built**

Parkinson Homes Yorkshire
 Parkinson House
 Fulford
 York
 YO30 4BE
 Tel: 01904 842199
 Fax: 01904 666142
 www.parkinsonhomes.com

Scale: 1:100 @ A3	Drawn: JBP	Date: Sept 17
File: R200mgm1/Pickering, Firlands Road/Phase 2/AD1/1.2.1/1.2.2.3		

Drawing No: PC2 / CA / A3 / Planning / 01	Rev: -
--	-----------

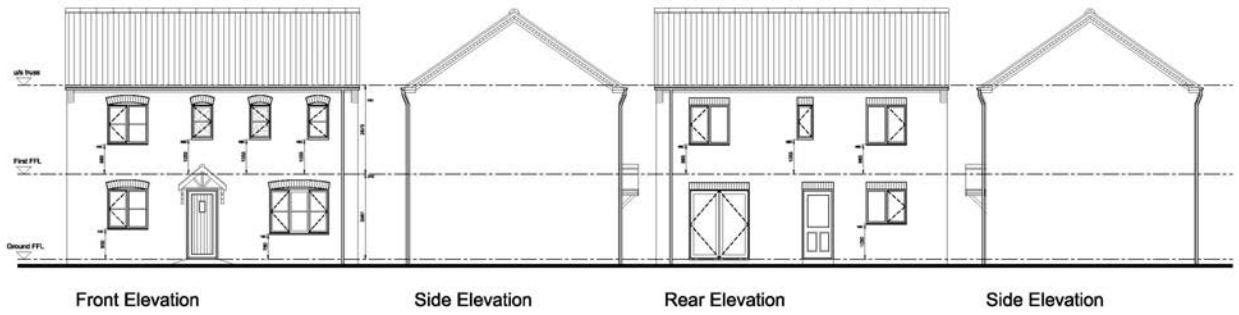


Front Elevation

Side Elevation

Rear Elevation

Side Elevation

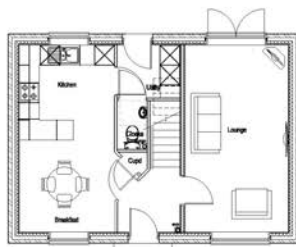

Ground Floor



First Floor

Rev	Description

Development
**Firlands Road
 Pickering
 Phase 2**


Drawing Title
**The Clayton Housetype
 Planning Drawing
 Op Built**

Parkinson Homes Yorkshire
 Parkinson House
 Fulford
 York
 YO30 4BE
 Tel: 01904 842199
 Fax: 01904 566142
 www.parkinsonhomes.com

THIS COPY HAD BEEN MADE BY OR WITH THE AUTHORITY OF RYEDALE DISTRICT COUNCIL PURSUANT TO SECTION 47 OF THE COPYRIGHT DESIGNS AND PATENTS ACT 1988. UNLESS THAT ACT PROVIDES A RELEVANT EXCEPTION TO COPYRIGHT, THE COPY MUST NOT BE COPIED WITHOUT THE PRIOR PERMISSION OF THE COPYRIGHT OWNER.



Scale: 1:100 @ A3	Drawn: JBP	Date: Sept 17
File: R200mgm1\Pickering, Firlands Road\Phase 2\A01.1.2.1.2.2.2		
Drawing No: PC2 / CA / OP / Planning/ 01	Rev: -	

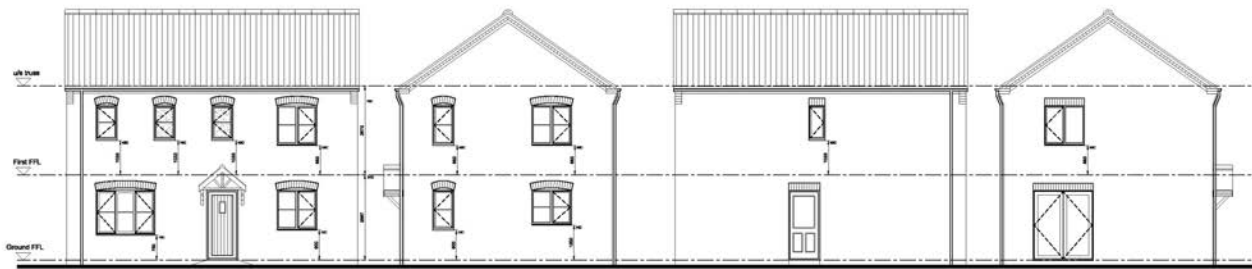

Front Elevation


Side Elevation

Rear Elevation

Side Elevation



Ground Floor

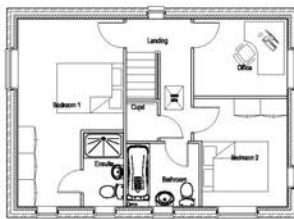

First Floor

Revisions

Development
 Firthlands Road
 Pickering
 Phase 2

Drawing Title
 The Clayton Corner Housetype
 Planning Drawing
 As Built


Parkinson Homes Yorkshire
 Parkinson House
 Fulford
 York
 YO30 4BE
 Tel: 01904 842199
 Fax: 01904 566142
 www.parkinsonhomes.com

THIS COPY HAD BEEN MADE BY OR WITH THE AUTHORITY OF RYEDALE DISTRICT COUNCIL PURSUANT TO SECTION 47 OF THE COPYRIGHT DESIGNS AND PATENTS ACT 1988. UNLESS THAT ACT PROVIDES A RELEVANT EXCEPTION TO COPYRIGHT, THE COPY MUST NOT BE COPIED WITHOUT THE PRIOR PERMISSION OF THE COPYRIGHT OWNER.

Scale: 1:100 @ A3 Drawn: JBP Date: Sept 17
 File: W200mgm1/Pickering, Firthlands Road/Phase 2/AD1/1.2.1/1.2.2.3

Drawing No: PC2 / CAC / AS / Planning / 01 Rev: -

Scale Bar: -
 5m 1:100

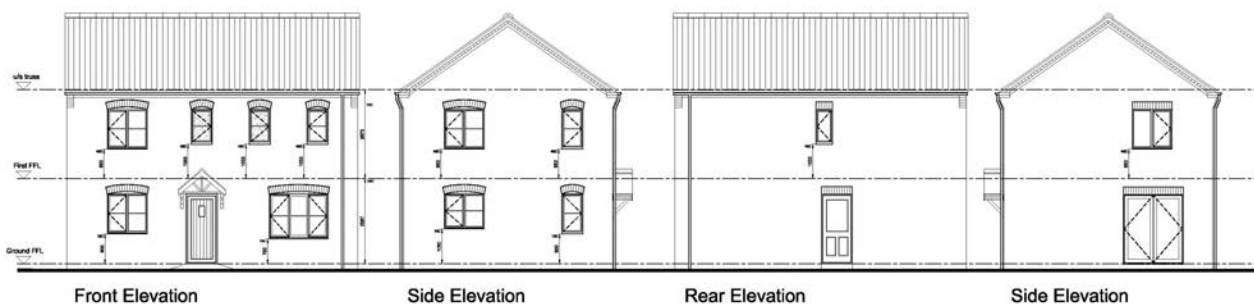


Front Elevation


Side Elevation

Rear Elevation

Side Elevation

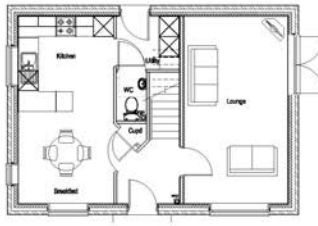

Ground Floor

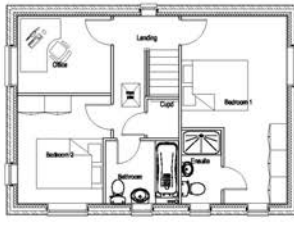


First Floor


Scale Bar: -
 5m 1:100

THIS COPY HAD BEEN MADE BY OR WITH THE AUTHORITY OF RYEDALE DISTRICT COUNCIL PURSUANT TO SECTION 47 OF THE COPYRIGHT DESIGNS AND PATENTS ACT 1988. UNLESS THAT ACT PROVIDES A RELEVANT EXCEPTION TO COPYRIGHT, THE COPY MUST NOT BE COPIED WITHOUT THE PRIOR PERMISSION OF THE COPYRIGHT OWNER.

Revisions
<p>Development</p> <p>Firlands Road Pickering Phase 2</p>
<p>Drawing Title</p> <p>The Clayton Corner Housetype Planning Drawing Op Built</p>
<p style="font-size: 8px;">Parkinson Homes Yorkshire Parkinson House Fulford York YO21 4EJ Tel: 01904 842199 Fax: 01904 666142 www.parkinsonhomes.com</p>
<p>Scale: 1:100 @ A3 Drawn: JBP Date: Sept 17</p> <p>File: R200mgm1/Pickering_Firlands Road/Phase 2/AD1/1.2.1/1.2.2.3</p>
<p>Drawing No: PC3 / OAC / OP / Planning / 01 Rev: -</p>

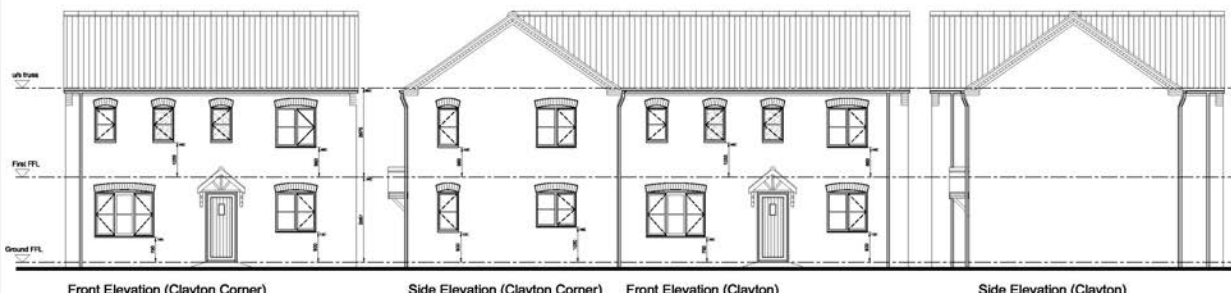

Front Elevation (Clayton Corner) Side Elevation (Clayton Corner) Front Elevation (Clayton) Side Elevation (Clayton)

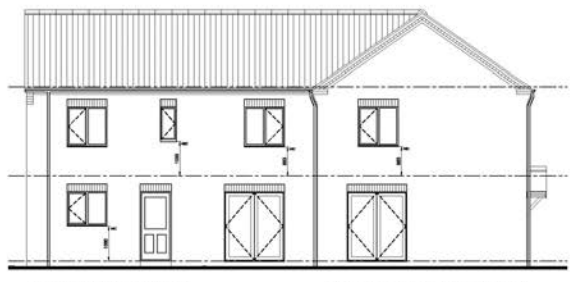

Rear Elevation (Clayton) Rear Elevation (Clayton Corner)

Revisions

Development
 Firthlands Road
 Pickering
 Phase 2

Drawing Title
 The Clayton Combination
 Planning Elevation




Parkinson Homes Yorkshire
 Parkinson House
 Fulford
 York
 YO3 4EJ
 Tel: 01904 842199
 Fax: 01904 566142
 www.parkinsonhomes.com

THIS COPY HAD BEEN MADE BY OR WITH THE AUTHORITY OF RYEDALE DISTRICT COUNCIL PURSUANT TO SECTION 47 OF THE COPYRIGHT DESIGNS AND PATENTS ACT 1988. UNLESS THAT ACT PROVIDES A RELEVANT EXCEPTION TO COPYRIGHT, THE COPY MUST NOT BE COPIED WITHOUT THE PRIOR PERMISSION OF THE COPYRIGHT OWNER.

Scale Bar: -
 5m 1:100

Scale: 1:100 @ A3	Drawn: JBP	Date: Sept 17
File: R:\2016\17\Pickering, Firthlands Road\Phase 2\A01-1.2.1.2.2.2		
Drawing No: PC2 / CA - CA2 / Planning / 01	Rev: -	

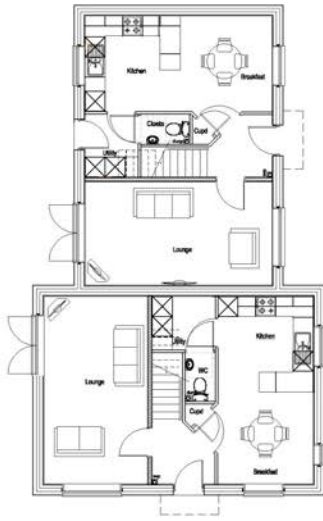

Ground Floor



First Floor

Scale Bar: -
 5m 1:100

THIS COPY HAD BEEN MADE BY OR WITH THE AUTHORITY OF RYEDALE DISTRICT COUNCIL PURSUANT TO SECTION 47 OF THE COPYRIGHT DESIGNS AND PATENTS ACT 1988. UNLESS THAT ACT PROVIDES A RELEVANT EXCEPTION TO COPYRIGHT, THE COPY MUST NOT BE COPIED WITHOUT THE PRIOR PERMISSION OF THE COPYRIGHT OWNER.

Revisions

Development
**Firlands Road
 Pickering
 Phase 2**

Drawing Title
**The Clayton Combination
 Planning Layout**



Parsons Homes Yorkshire
 Parsons House
 Fulford
 York
 YO10 4BE
 Tel: 01904 842199
 Fax: 01904 666142
 www.parsonshomes.com

Scale: 1:100 @ A3	Drawn: JBP	Date: Sept 17
File: H:\Morgans\Pickering, Firthland Road\Phase 2\A01\1.2.1\1.2.2.2		
Drawing No: PC2 / CA - CAC2 / Planning / 08	Rev: -	



Front Elevation

Side Elevation




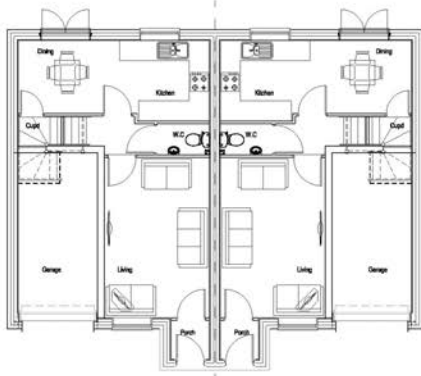
Rear Elevation

Side Elevation


THIS COPY HAD BEEN MADE BY OR WITH THE AUTHORITY OF RYEDALE DISTRICT COUNCIL PURSUANT TO SECTION 47 OF THE COPYRIGHT DESIGNS AND PATENTS ACT 1988. UNLESS THAT ACT PROVIDES A RELEVANT EXCEPTION TO COPYRIGHT, THE COPY MUST NOT BE COPIED WITHOUT THE PRIOR PERMISSION OF THE COPYRIGHT OWNER.

Scale Bar: -
 5m 1:100

Revisions	
Development Firthlands Road Pickering Phase 2	
Drawing Title The Chatsworth Housetype Planning Elevation 2 Block	
 Perkinson Homes Yorkshire Perkinson House Fulford York YO18 4TE Tel: 01904 842199 Fax: 01904 891442 www.perkinsonhomes.com	
Scale: 1:100 @ A3	Drawn: JBP Date: Oct 17
File: S:\urugon\1\Pickering, Firthlands Road Phase 2\1A01.1.01.1.2.1.2.2.3	
Drawing No. PK2 / CH / 2B / Planning / 01	Rev -




Ground Floor

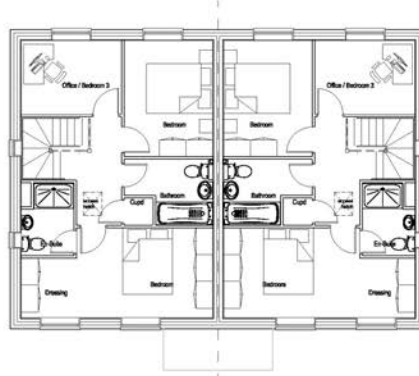

First Floor

Scale Bar: -
 5m 1:100

THIS COPY HAD BEEN MADE BY OR WITH THE AUTHORITY OF RYEDALE DISTRICT COUNCIL PURSUANT TO SECTION 47 OF THE COPYRIGHT DESIGNS AND PATENTS ACT 1988. UNLESS THAT ACT PROVIDES A RELEVANT EXCEPTION TO COPYRIGHT, THE COPY MUST NOT BE COPIED WITHOUT THE PRIOR PERMISSION OF THE COPYRIGHT OWNER.

Revisions	
Development Firthlands Road Pickering Phase 2	
Drawing Title The Chatsworth Housetype Planning Layout 2 Block	
 Permisson Homes Yorkshire Permisson House Fulford York YO18 4TE Tel : 01904 842199 Fax : 01904 891142 www.permissonhomes.com	
Scale: 1:100 @ A3	Drawn: JBP
Date: Oct 17	
File: S:\Munro\1\Pickering, Firthlands Road Phase 2\1A01.1.0.1.0.2.1.0.2.3	
Drawing No. PG2 / CH / 2B / Planning / 02	Rev -




Front Elevation


Side Elevation

Rear Elevation

Side Elevation

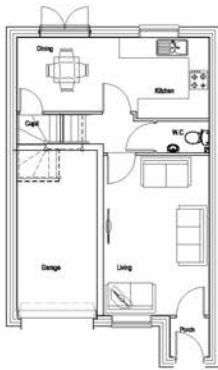

Ground Floor

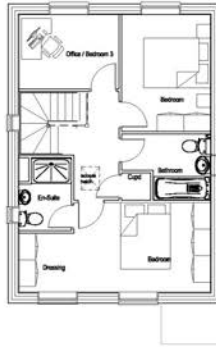

First Floor

Revisions

Development
**Firthlands Road
 Pickering
 Phase 2**

Drawing Title
**The Chatsworth Housetype
 Planning Drawing
 As Built**



Permisson Homes Yorkshire
 Permisson House
 Fulford
 York
 YO18 4TE
 Tel: 01904 842999
 Fax: 01904 890142
 www.permissonhomes.com

Scale: 1:100 @ A3	Drawn: JSP	Date: Sept 17
File: M:\morgon\1\Pickering, Firthlands Road Phase 2\A01\1.0\1.02.1.02.3		

Drawing No:	PK2 / CH / A3 / Planning / 01	Rev:	-
-------------	-------------------------------	------	---

THIS COPY HAD BEEN MADE BY OR WITH THE AUTHORITY OF RYEDALE DISTRICT COUNCIL PURSUANT TO SECTION 47 OF THE COPYRIGHT DESIGNS AND PATENTS ACT 1988. UNLESS THAT ACT PROVIDES A RELEVANT EXCEPTION TO COPYRIGHT, THE COPY MUST NOT BE COPIED WITHOUT THE PRIOR PERMISSION OF THE COPYRIGHT OWNER.

Scale Bar: -
 5m 1:100




Front Elevation


Side Elevation

Rear Elevation

Side Elevation

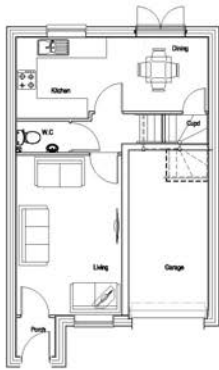

Ground Floor

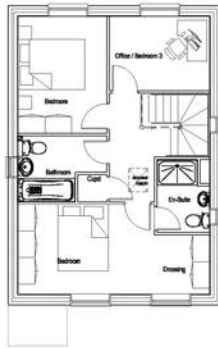

First Floor

Revisions

Development
**Firhlands Road
 Pickering
 Phase 2**

Drawing Title
**The Chatsworth Housetype
 Planning Drawing
 Op Built**



Permitted Homes Yorkshire
 Permitted Homes
 Fullford
 York
 YO18 4TE
 Tel: 01904 842990
 Fax: 01904 890142
 www.permittedhomes.com

Scale: 1:100 @ A3 Drawn: JBP Date: Sept 17
 File: M:\morgon\1\Pickering, Firhlands Road Phase 2\A01\1.0\1.02.1.02.3

Drawing No. Rev
 PG2 / CH / OP / Planning / 01 1

THIS COPY HAD BEEN MADE BY OR WITH THE AUTHORITY OF RYEDALE DISTRICT COUNCIL PURSUANT TO SECTION 47 OF THE COPYRIGHT DESIGNS AND PATENTS ACT 1988. UNLESS THAT ACT PROVIDES A RELEVANT EXCEPTION TO COPYRIGHT, THE COPY MUST NOT BE COPIED WITHOUT THE PRIOR PERMISSION OF THE COPYRIGHT OWNER.

Scale Bar: -
 5m 1:100




Front Elevation

Side Elevation

Rear Elevation

Side Elevation

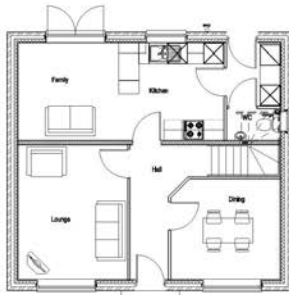

Ground Floor



First Floor

Revisions

Development
**Firlands Road
 Pickering
 Phase 2**

Drawing Title
**The Chedworth Housetype
 Planning Elevations
 As Built**

Parkinson Homes Yorkshire
 Parkinson House
 Fulford
 York
 YO30 4BE
 Tel: 01904 842199
 Fax: 01904 666142
 www.parkinsonhomes.com

THIS COPY HAD BEEN MADE BY OR WITH THE AUTHORITY OF RYEDALE DISTRICT COUNCIL PURSUANT TO SECTION 47 OF THE COPYRIGHT DESIGNS AND PATENTS ACT 1988. UNLESS THAT ACT PROVIDES A RELEVANT EXCEPTION TO COPYRIGHT, THE COPY MUST NOT BE COPIED WITHOUT THE PRIOR PERMISSION OF THE COPYRIGHT OWNER.

Scale: 1:100 @ A3	Drawn: JBP	Date: Oct 2017
File: W20170919 Pickering, Fulford Rear1.A3 1:21.12.17.12.3		

Drawing No: PK2 / CW / AS / Planning / 01	Rev: -
---	--------

Scale Bar: -
 5m 1:100



Front Elevation

Side Elevation

Rear Elevation

Side Elevation



Ground Floor



First Floor

Revisions

Development
**Firlands Road
 Pickering
 Phase 2**

Drawing Title
**The Chedworth Housetype
 Planning Elevations
 Op Built**



THIS COPY HAD BEEN MADE BY OR WITH THE AUTHORITY OF RYEDALE DISTRICT COUNCIL PURSUANT TO SECTION 47 OF THE COPYRIGHT DESIGNS AND PATENTS ACT 1988. UNLESS THAT ACT PROVIDES A RELEVANT EXCEPTION TO COPYRIGHT, THE COPY MUST NOT BE COPIED WITHOUT THE PRIOR PERMISSION OF THE COPYRIGHT OWNER.

Scale: 1:100 @ A3	Drawn: JBP	Date: Oct 2017
File: R32000001/Pickering_Fulford_Rear1.rvt 1.0.1.2.1.2.2.3		
Drawing No: PK2 / CW / OP / Planning / 01	Rev: -	






Front Elevation (Garage Side)

Front Elevation (Front Door Side)


Rear Elevation



Ground Floor

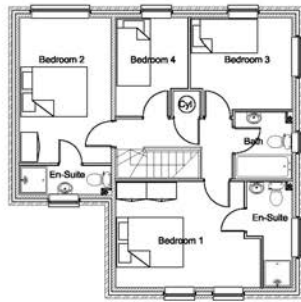

First Floor

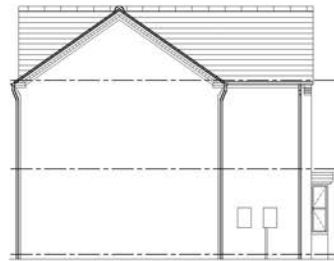

Side Elevation

Revisions

Development
Firthlands Road
Pickering
Phase 2

Drawing Title
The Escrick Housetype
Planning Drawing
As Built



Parkinson Homes Yorkshire
 Parkinson House
 Fulford
 York
 YO10 4BE
 Tel: 01904 842199
 Fax: 01904 666142
 www.parkinsonhomes.com

Scale: 1:100 @ A3	Drawn: JBP	Date: Oct 2017
File: H2016019 (Pickering, Firthlands Road) AP1 1.0.1.2.1.2.2.3		

Drawing No: PK2 / ES / AS / Planning / 01	Rev: -
---	--------

Scale Bar: -
 5m 1:100

THIS COPY HAD BEEN MADE BY OR WITH THE AUTHORITY OF RYEDALE DISTRICT COUNCIL PURSUANT TO SECTION 47 OF THE COPYRIGHT DESIGNS AND PATENTS ACT 1988. UNLESS THAT ACT PROVIDES A RELEVANT EXCEPTION TO COPYRIGHT, THE COPY MUST NOT BE COPIED WITHOUT THE PRIOR PERMISSION OF THE COPYRIGHT OWNER.



Front Elevation (Garage)

Front Elevation (Front Door)


Rear Elevation



Ground Floor



First Floor

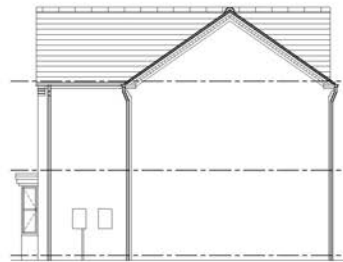

Side Elevation

Revisions

Development
**Firthlands Road
 Pickering
 Phase 2**

Drawing Title
**The Escrick Housetype
 Planning Drawing
 Op Built**




Parkinson Homes Yorkshire
 Parkinson House
 Fulford
 York
 YO18 4BE
 Tel: 01904 842199
 Fax: 01904 556142
 www.parkinsonhomes.com

Scale: 1:100 @ A3	Drawn: JBP	Date: Oct 2017
File: H3000001/Pickering_Fulford_Rear1/APP1/2/1/2/1/2/2.3		

Drawing No: PK2 / ES / OP / Planning / 01	Rev: -
---	--------

Scale Bar: -
 5m 1:100


THIS COPY HAD BEEN MADE BY OR WITH THE AUTHORITY OF RYEDALE DISTRICT COUNCIL PURSUANT TO SECTION 47 OF THE COPYRIGHT DESIGNS AND PATENTS ACT 1988. UNLESS THAT ACT PROVIDES A RELEVANT EXCEPTION TO COPYRIGHT, THE COPY MUST NOT BE COPIED WITHOUT THE PRIOR PERMISSION OF THE COPYRIGHT OWNER.

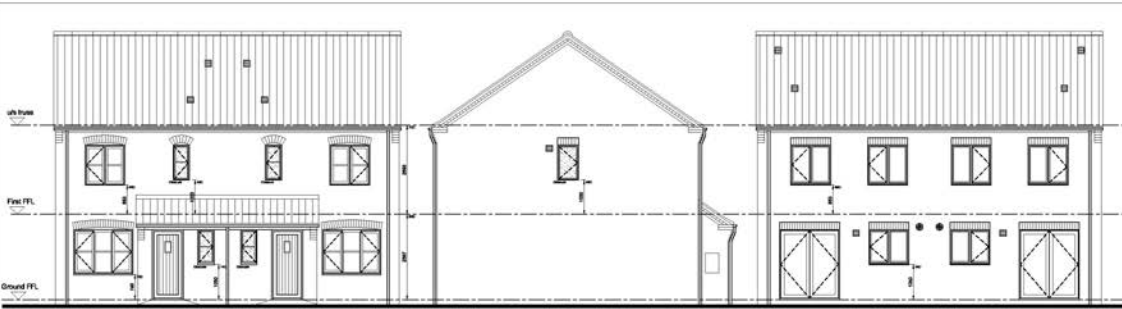


Front Elevation

Side Elevation


Rear Elevation

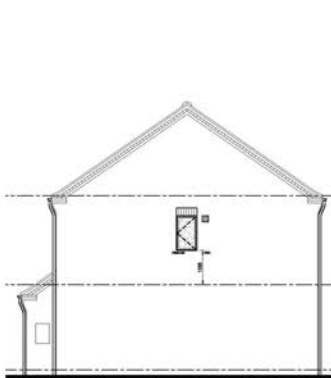

Side Elevation

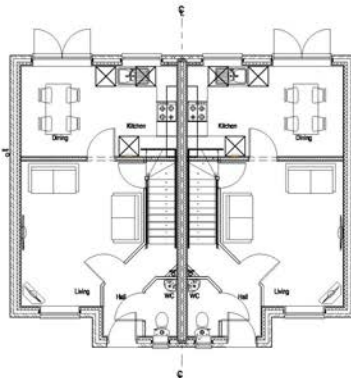


Ground Floor



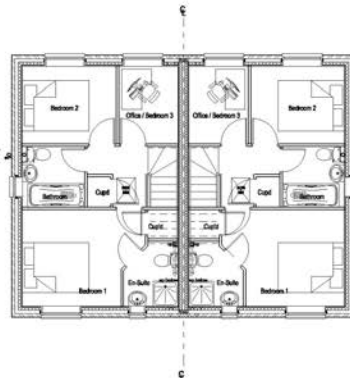


First Floor



THIS COPY HAD BEEN MADE BY OR WITH THE AUTHORITY OF RYEDALE DISTRICT COUNCIL PURSUANT TO SECTION 47 OF THE COPYRIGHT DESIGNS AND PATENTS ACT 1988. UNLESS THAT ACT PROVIDES A RELEVANT EXCEPTION TO COPYRIGHT, THE COPY MUST NOT BE COPIED WITHOUT THE PRIOR PERMISSION OF THE COPYRIGHT OWNER.

Revisions	
Development Firlands Road Pickering Phase 2	
Drawing Title The Hanbury Housetype Planning Drawing 2 Block	
 Parkinson Homes Yorkshire Parkinson House Fulford York YO10 4BE Tel: 01904 842199 Fax: 01904 666142 www.parkinsonhomes.com	
Scale: 1:100 @ A3	Drawn: JBP
Date: Sept 17	
File: R:\Birmingham\Pickering, Firlands Road\Phase 2\A01\1.2.1\1.2.2.2	
Drawing No: PC2 / HA / 28 / Planning / 01	Rev: -

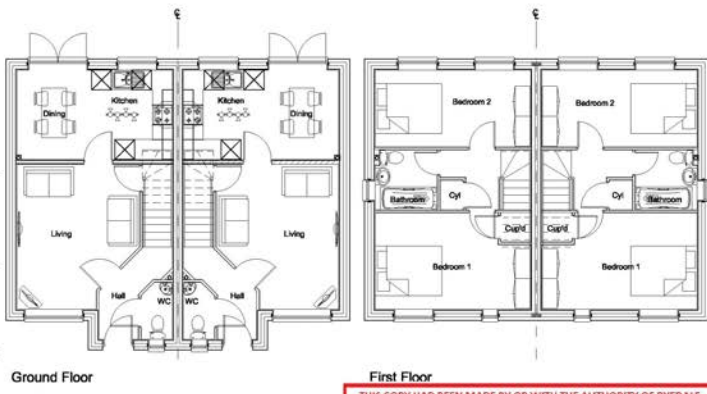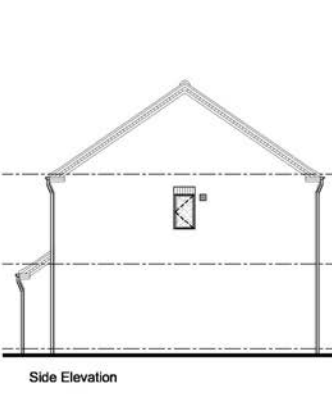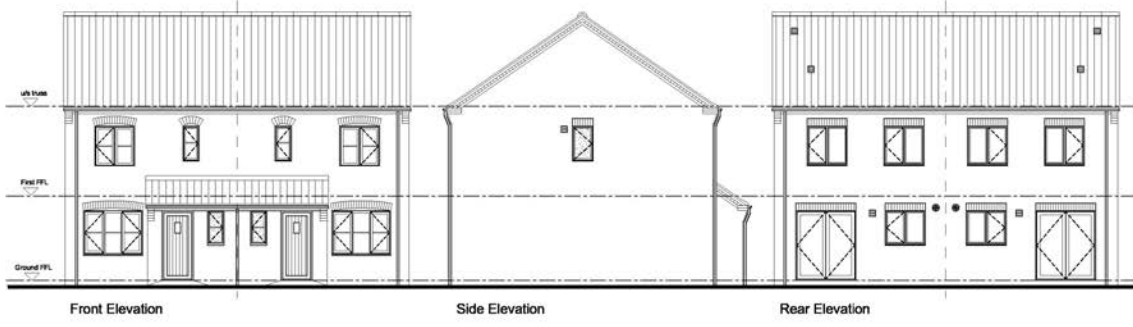

Scale Bar: -
 5m 1:100


THIS COPY HAD BEEN MADE BY OR WITH THE AUTHORITY OF RYEDALE DISTRICT COUNCIL PURSUANT TO SECTION 47 OF THE COPYRIGHT DESIGNS AND PATENTS ACT 1988. UNLESS THAT ACT PROVIDES A RELEVANT EXCEPTION TO COPYRIGHT, THE COPY MUST NOT BE COPIED WITHOUT THE PRIOR PERMISSION OF THE COPYRIGHT OWNER.

Revisors	
Development	Firthlands Road Pickering Phase 2
Drawing Title	The Howard Housetype Planning Drawing 2 Block
 Parsons Homes Yorkshire Parsons House Fulford York YO19 4BE Tel: 01904 842199 Fax: 01904 666142 www.parsonshomes.com	
Scale: 1:100 @ A3	Drawn: JBP Date: Oct 2017
File: H:\Planning\Pickering_Fulford\Res1\AP1\1.0\1.2\1.2.2.3	
Drawing No: PC2 / HO / 28 / Planning / 01	Rev: -



Front Elevation

Side Elevation

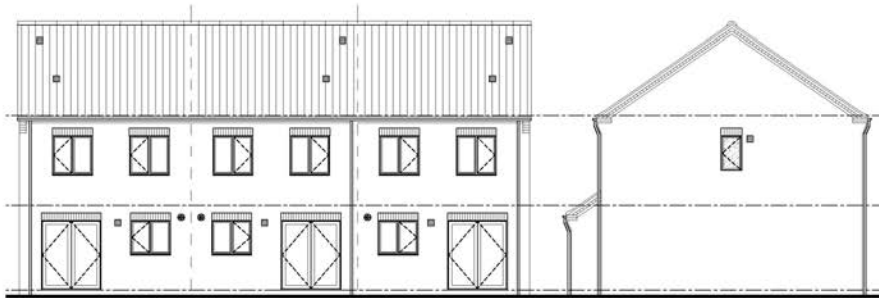


Rear Elevation

Side Elevation


Scale Bar: -
 5m 1:100

THIS COPY HAD BEEN MADE BY OR WITH THE AUTHORITY OF RYEDALE DISTRICT COUNCIL PURSUANT TO SECTION 47 OF THE COPYRIGHT DESIGNS AND PATENTS ACT 1988. UNLESS THAT ACT PROVIDES A RELEVANT EXCEPTION TO COPYRIGHT, THE COPY MUST NOT BE COPIED WITHOUT THE PRIOR PERMISSION OF THE COPYRIGHT OWNER.

Revisions	
Development Firthlands Road Pickering Phase 2	
Drawing Title The Howard Housetype Planning Elevations 3 Block	
 Perkinson Homes Yorkshire House Fulford York YO18 4BE Tel: 01904 842199 Fax: 01904 666142 www.perkinsonhomes.com	
Scale: 1:100 @ A3	Drawn: JBP Date: Oct 2017
File: \\S:\eng\p\pickering_firthlands\rear\1\01_12_17\1223	
Drawing No: PK2 / HO / 3B / Planning / 01	Rev: -

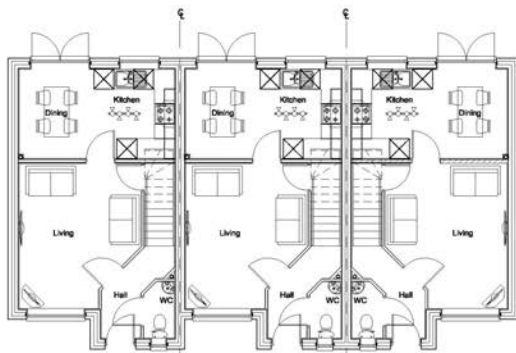


Ground Floor

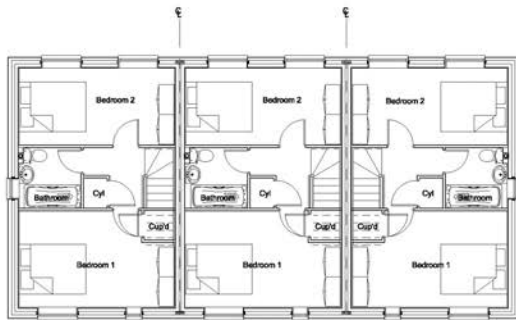


First Floor



THIS COPY HAD BEEN MADE BY OR WITH THE AUTHORITY OF RYEDALE DISTRICT COUNCIL PURSUANT TO SECTION 47 OF THE COPYRIGHT DESIGNS AND PATENTS ACT 1988. UNLESS THAT ACT PROVIDES A RELEVANT EXCEPTION TO COPYRIGHT, THE COPY MUST NOT BE COPIED WITHOUT THE PRIOR PERMISSION OF THE COPYRIGHT OWNER.


Revisors	
Development Firthlands Road Pickering Phase 2	
Drawing Title The Howard Housetype Planning Layouts 3 Block	
 Parkinson Homes Yorkshire Parkinson House Fulford York YO10 4BE Tel: 01904 842199 Fax: 01904 566142 www.parkinsonhomes.com	
Scale: 1:100 @ A3	Drawn: JBP Date: Oct 2017
File: H:\Morgans\Pickering, Firthlands Road\1\A1\1.0\1.2\1.2.3	
Drawing No: PK2 / HO / 3B / Planning / 02	Rev: -




Revisors	
Development Firthlands Road Pickering Phase 2	
Drawing Title The Howard Housetype Planning Elevations 4 Block	
 Parsons Homes Yorkshire Parsons House Fulford York YO10 4BE Tel: 01904 842199 Fax: 01904 566142 www.parsonshomesyork.com	
Scale: 1:100 @ A3	Drawn: JBP Date: Oct 2017
File: H:\Drawings\Planning, Fulford\Rear1\A11.1.2.1.2.2.3	
Drawing No: PC2 / HO1 / 4B / Planning / 01	Rev: -

THIS COPY HAD BEEN MADE BY OR WITH THE AUTHORITY OF RYEDALE DISTRICT COUNCIL PURSUANT TO SECTION 47 OF THE COPYRIGHT DESIGNS AND PATENTS ACT 1988. UNLESS THAT ACT PROVIDES A RELEVANT EXCEPTION TO COPYRIGHT, THE COPY MUST NOT BE COPIED WITHOUT THE PRIOR PERMISSION OF THE COPYRIGHT OWNER.

Scale Bar: -
5m 1:100

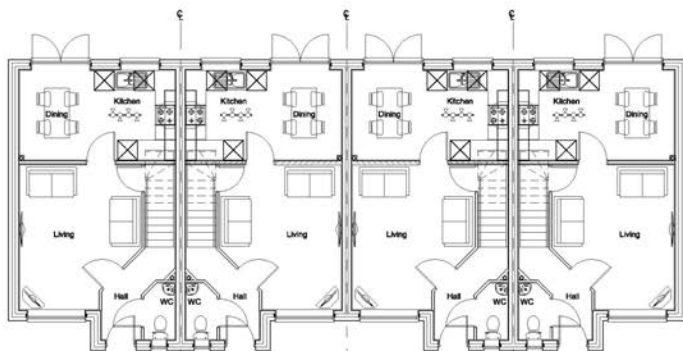


Ground Floor

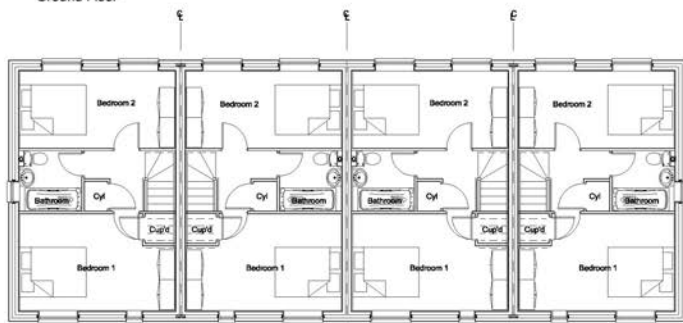


First Floor

Scale Bar: -
 5m 1:100

THIS COPY HAD BEEN MADE BY OR WITH THE AUTHORITY OF RYEDALE DISTRICT COUNCIL PURSUANT TO SECTION 47 OF THE COPYRIGHT DESIGNS AND PATENTS ACT 1988. UNLESS THAT ACT PROVIDES A RELEVANT EXCEPTION TO COPYRIGHT, THE COPY MUST NOT BE COPIED WITHOUT THE PRIOR PERMISSION OF THE COPYRIGHT OWNER.

Revisors	
Development Firthlands Road Pickering Phase 2	
Drawing Title The Howard Housetype Planning Layouts 4 Block	
 Parsons Homes Yorkshire House Fulford York YO18 4BE Tel: 01904 842199 Fax: 01904 666142 www.parsonshomes.com	
Scale: 1:100 @ A3	Drawn: JBP Date: Oct 2017
File: \\Birmingham\Planning_Fulford\Res1\AP1\2017\21\223	
Drawing No: PK2 / HO1 / 4B / Planning / 02	Rev: -

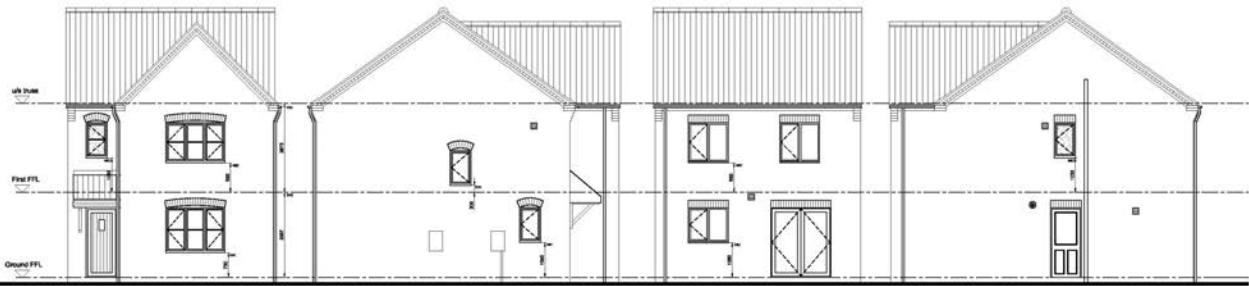


Front Elevation


Side Elevation

Rear Elevation

Side Elevation

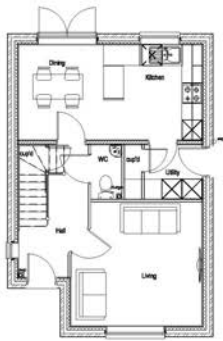

Ground Floor

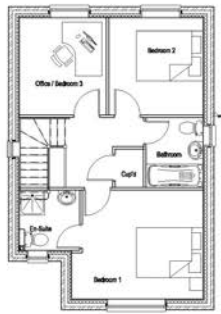


First Floor



THIS COPY HAD BEEN MADE BY OR WITH THE AUTHORITY OF RYEDALE DISTRICT COUNCIL PURSUANT TO SECTION 47 OF THE COPYRIGHT DESIGNS AND PATENTS ACT 1988. UNLESS THAT ACT PROVIDES A RELEVANT EXCEPTION TO COPYRIGHT, THE COPY MUST NOT BE COPIED WITHOUT THE PRIOR PERMISSION OF THE COPYRIGHT OWNER.

Revisions			
Development Firthlands Road Pickering Phase 2			
Drawing Title The Hatfield Housetype Planning Drawing As Built			
 Parsons Homes Yorkshire Parsons House Fulford York YO30 4BE Tel: 01904 842199 Fax: 01904 666142 www.parsonshomes.com			
Scale: 1:100 @ A3	Drawn: JBP	Date: Oct 2017	
File: W:\Drawing\Pickering, Firthlands Road\AP1\02\12\1223			
Drawing No: PK2 / HT / AS / Planning / 01	Rev: -		

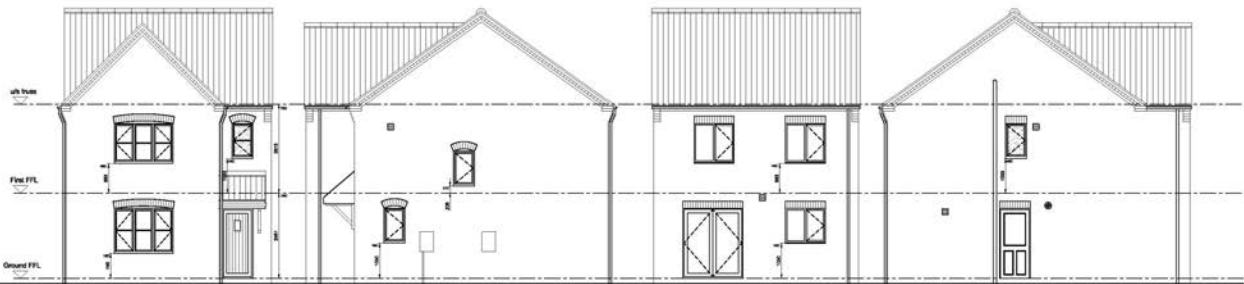


Front Elevation

Side Elevation

Rear Elevation

Side Elevation

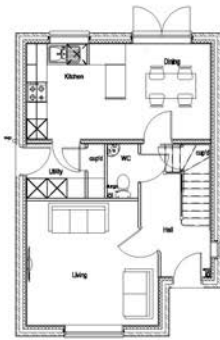

Ground Floor



First Floor



THIS COPY HAD BEEN MADE BY OR WITH THE AUTHORITY OF RYEDALE DISTRICT COUNCIL PURSUANT TO SECTION 47 OF THE COPYRIGHT DESIGNS AND PATENTS ACT 1988. UNLESS THAT ACT PROVIDES A RELEVANT EXCEPTION TO COPYRIGHT, THE COPY MUST NOT BE COPIED WITHOUT THE PRIOR PERMISSION OF THE COPYRIGHT OWNER.

Revisions			
Development Firlands Road Pickering Phase 2			
Drawing Title The Hatfield Housetype Planning Drawing Op Built			
 Perkinson Homes Yorkshire Perkinson House Fulford York YO19 4BE Tel: 01904 842199 Fax: 01904 666142 www.perkinsonhomes.com			
Scale: 1:100 @ A3	Drawn: JBP	Date: Oct 2017	
File: R32000001/Pickering, Firlands Road/1/HT/1.0/1.0/1.0/1.0/1.0			
Drawing No: PK2 / HT / OP / Planning / 01	Rev: -		



Front Elevation

Side Elevation




Rear Elevation


Side Elevation

Scale Bar: -


 5m 1:100

THIS COPY HAD BEEN MADE BY OR WITH THE AUTHORITY OF RYEDALE DISTRICT COUNCIL PURSUANT TO SECTION 47 OF THE COPYRIGHT DESIGNS AND PATENTS ACT 1988. UNLESS THAT ACT PROVIDES A RELEVANT EXCEPTION TO COPYRIGHT, THE COPY MUST NOT BE COPIED WITHOUT THE PRIOR PERMISSION OF THE COPYRIGHT OWNER.


Revisions			
Development Firthlands Road Pickering Phase 2			
Drawing Title The Leicester Housetype Planning Elevation 2 Block			
 Parsons Homes Yorkshire Parsons House Fulford York YO3 4BE Tel: 01904 842199 Fax: 01904 566142 www.parsonshomes.com			
Scale:	1:100 @ A3	Drawn:	JBP
Date:	Oct 2017		
File:	R20170101 (Pickering, Firthlands Road) 1.01.1.01.1.01.01.01.01		
Drawing No:	PK2 / LE / 20 / Planning/01	Rev:	-

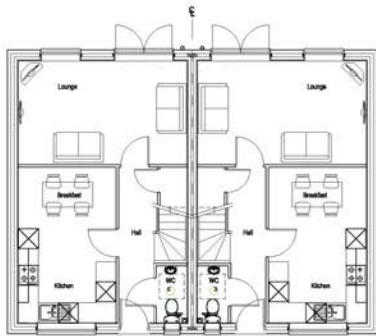

Ground Floor

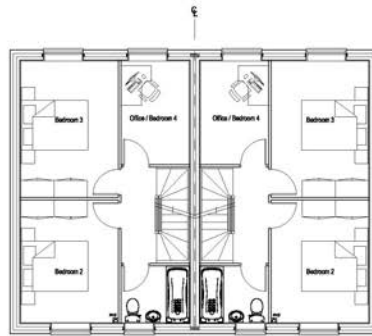

First Floor

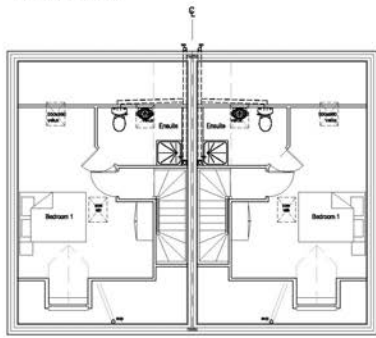


Second Floor

Scale Bar: -

 5m 1:100


THIS COPY HAD BEEN MADE BY OR WITH THE AUTHORITY OF RYEDALE DISTRICT COUNCIL PURSUANT TO SECTION 47 OF THE COPYRIGHT DESIGNS AND PATENTS ACT 1988. UNLESS THAT ACT PROVIDES A RELEVANT EXCEPTION TO COPYRIGHT, THE COPY MUST NOT BE COPIED WITHOUT THE PRIOR PERMISSION OF THE COPYRIGHT OWNER.

Revisions			
Development Firthlands Road Pickering Phase 2			
Drawing Title The Leicester Housetype Planning Layouts 2 Block			
 Parsimmon Homes Yorkshire Parsimmon House Fulford York YO30 4BE Tel: 01904 842199 Fax: 01904 666142 www.parsimmonhomes.com			
Scale:	1:100 @ A3	Drawn:	JBP
Date:	Oct 2017		
File:	R20170919 Pickering, Firthlands Road 1, AP1, 1.0, 1.1, 1.2, 1.3, 1.4		
Drawing No:	PK2 / LE / 20 / Planning / 02	Rev:	-



Front Elevation

Rear Elevation

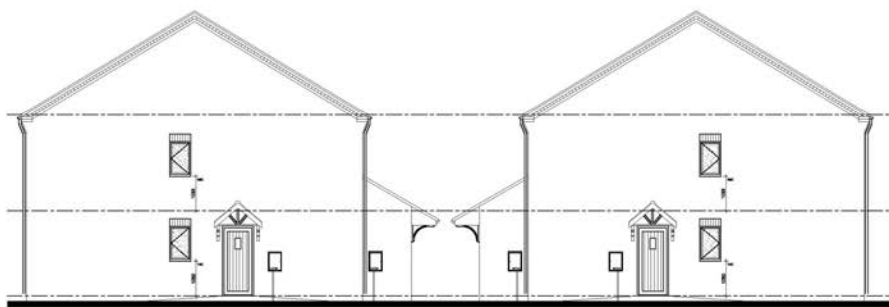


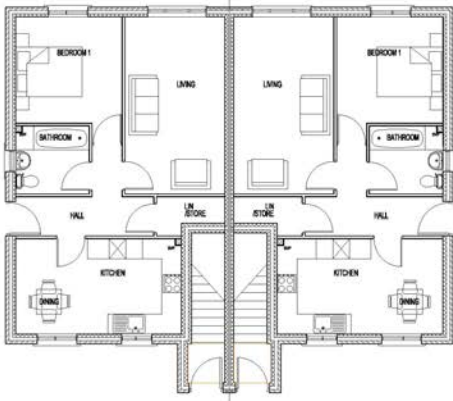
Side Elevation

Side Elevation


THIS COPY HAD BEEN MADE BY OR WITH THE AUTHORITY OF RYEDALE DISTRICT COUNCIL PURSUANT TO SECTION 47 OF THE COPYRIGHT DESIGNS AND PATENTS ACT 1988. UNLESS THAT ACT PROVIDES A RELEVANT EXCEPTION TO COPYRIGHT, THE COPY MUST NOT BE COPIED WITHOUT THE PRIOR PERMISSION OF THE COPYRIGHT OWNER.

Scale Bar: -
 5m 1:100

Revisions		
Development		
Firthlands Road Pickering Phase 2		
Drawing Title		
The Linton Housetype Planning Elevation 2 Block		
 Persimmon Homes Yorkshire Persimmon House Fulford York YO18 4FE Tel: 01904 662199 Fax: 01904 699142 www.persimmonhomes.com		
Scale:	Drawn:	Date:
1:100 @ A3	JSP	Oct 2017
File: 01000001 Pickering, Firthlands Road 1401 1201 121 1223		
Drawing No.	Rev	
PC2 / L1 / 28 / Planning / 01		



Ground Floor

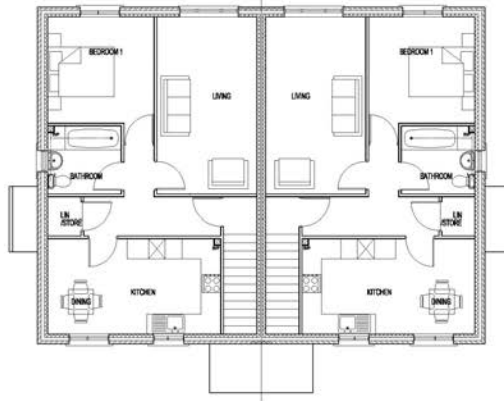

First Floor




THIS COPY HAD BEEN MADE BY OR WITH THE AUTHORITY OF RYEDALE DISTRICT COUNCIL PURSUANT TO SECTION 47 OF THE COPYRIGHT DESIGNS AND PATENTS ACT 1988. UNLESS THAT ACT PROVIDES A RELEVANT EXCEPTION TO COPYRIGHT, THE COPY MUST NOT BE COPIED WITHOUT THE PRIOR PERMISSION OF THE COPYRIGHT OWNER.

Revisions

Development
**Firthlands Road
 Pickering
 Phase 2**

Drawing Title
**The Linton Housetype
 Planning Layouts
 2 Block**

 Persimmon Homes Yorkshire
 Persimmon House
 Fulford
 York
 YO10 4FE
 Tel: 01904 662199
 Fax: 01904 699142
 www.persimmonhomes.com

Scale:	1:100 @ A3	Drawn:	JSP	Date:	Oct 2017
File:	S:\Drawings\1\Pickering, Firthlands Road\14011201\21\223				
Drawing No.	PC2 / L1 / 28 / Planning / 02	Rev	-		




Front Elevation


Side Elevation

Rear Elevation

Side Elevation

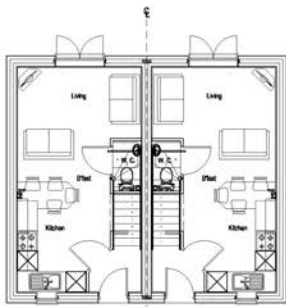

Ground Floor

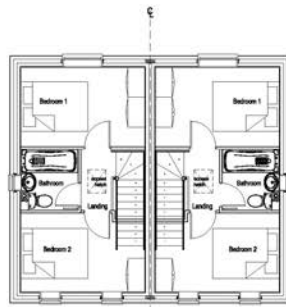


First Floor

Scale Bar: -
 5m 1:100

THIS COPY HAD BEEN MADE BY OR WITH THE AUTHORITY OF RYEDALE DISTRICT COUNCIL PURSUANT TO SECTION 47 OF THE COPYRIGHT DESIGNS AND PATENTS ACT 1988. UNLESS THAT ACT PROVIDES A RELEVANT EXCEPTION TO COPYRIGHT, THE COPY MUST NOT BE COPIED WITHOUT THE PRIOR PERMISSION OF THE COPYRIGHT OWNER.


Revisions	
Development Firthlands Road Pickering Phase 2	
Drawing Title The Morden Housetype Planning Drawing 2 Block	
 Parkinson Homes Yorkshire House Fulford York YO19 4BE Tel: 01904 842199 Fax: 01904 666142 www.parkinsonhomes.com	
Scale: 1:100 @ A3	Drawn: JBP
Date: Sept 17	
File: M20morden1/Pickering_Fulford_Rear/Phase 2/AD1/1.2.1/1.2.2.2	
Drawing No. PC2 / MR / 20 / Planning / 01	Rev -

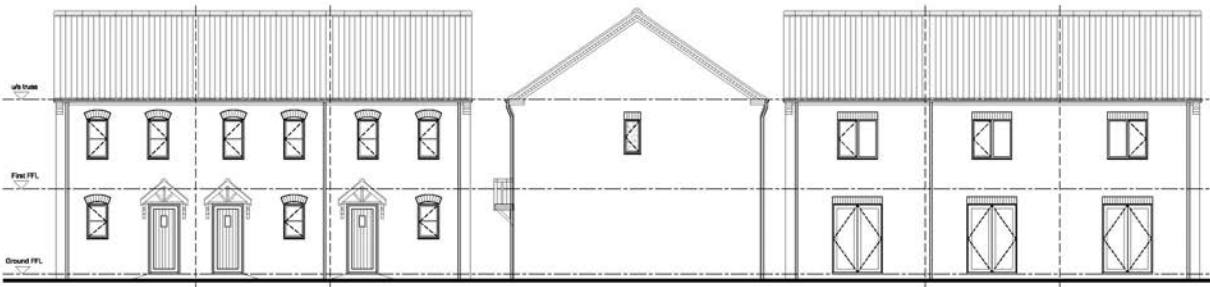

Front Elevation

Side Elevation

Rear Elevation

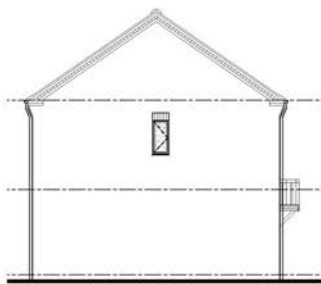

Side Elevation

Scale Bar: -



THIS COPY HAD BEEN MADE BY OR WITH THE AUTHORITY OF RYEDALE DISTRICT COUNCIL PURSUANT TO SECTION 47 OF THE COPYRIGHT DESIGNS AND PATENTS ACT 1988. UNLESS THAT ACT PROVIDES A RELEVANT EXCEPTION TO COPYRIGHT, THE COPY MUST NOT BE COPIED WITHOUT THE PRIOR PERMISSION OF THE COPYRIGHT OWNER.

Revisions

Development
**Firlands Road
 Pickering
 Phase 2**


Drawing Title
**The Morden Housetype
 Planning Elevation
 3 Block**




Parkinson Homes Yorkshire
 Parkinson House
 Fulford
 York
 YO10 4BE
 Tel: 01904 842199
 Fax: 01904 666142
 www.parkinsonhomes.com

Scale: 1:100 @ A3	Drawn: JBP	Date: Sept 17
File: R200mgm1/Pickering, Firlands Road/Phase 2/AD1/1.2.1/2.2.2		

Drawing No. PC2 / MR / 30 / Planning / 01	Rev. -
--	-----------

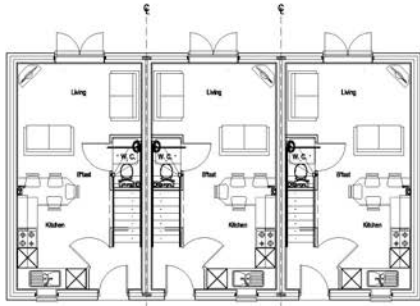


Ground Floor

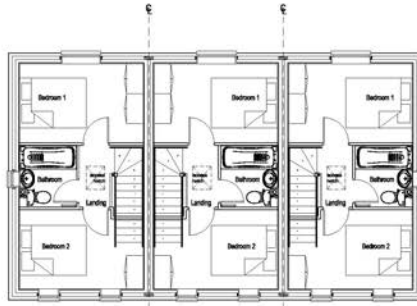


First Floor

Scale Bar: -
 5m 1:100


THIS COPY HAD BEEN MADE BY OR WITH THE AUTHORITY OF RYEDALE DISTRICT COUNCIL PURSUANT TO SECTION 47 OF THE COPYRIGHT DESIGNS AND PATENTS ACT 1988. UNLESS THAT ACT PROVIDES A RELEVANT EXCEPTION TO COPYRIGHT, THE COPY MUST NOT BE COPIED WITHOUT THE PRIOR PERMISSION OF THE COPYRIGHT OWNER.

Revisions	
Development Firthlands Road Pickering Phase 2	
Drawing Title The Morden Housetype Planning Layouts 3 Block	
 Parsons Homes Yorkshire Parsons House Fulford York YO21 4BE Tel: 01904 842199 Fax: 01904 666142 www.parsonshomes.com	
Scale: 1:100 @ A3	Drawn: JBP Date: Sept 17
File: H200mgm1/Pickering, Firthlands Road/Phase 2/A01.1.2.1.2.2.2	
Drawing No. PC2 / MR / 30 / Planning / 02	Rev: -

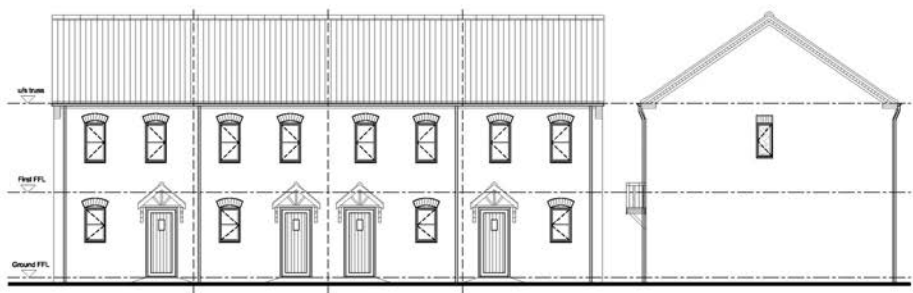

Front Elevation

Side Elevation

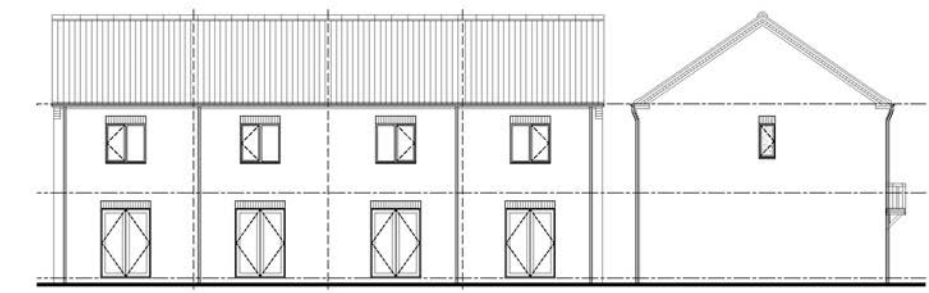

Rear Elevation

Side Elevation



THIS COPY HAD BEEN MADE BY OR WITH THE AUTHORITY OF RYEDALE DISTRICT COUNCIL PURSUANT TO SECTION 47 OF THE COPYRIGHT DESIGNS AND PATENTS ACT 1988. UNLESS THAT ACT PROVIDES A RELEVANT EXCEPTION TO COPYRIGHT, THE COPY MUST NOT BE COPIED WITHOUT THE PRIOR PERMISSION OF THE COPYRIGHT OWNER.


Revisions

Development
**Firlands Road
 Pickering
 Phase 2**


Drawing Title
**The Morden Housetype
 Planning Elevation
 4 Block**

Parkinson Homes Yorkshire
 Parkinson House
 Fulford
 York
 YO3 4BE
 Tel: 01904 842199
 Fax: 01904 666142
 www.parkinsonhomes.com

Scale: 1:100 @ A3	Drawn: JBP	Date: Sept 17
File: M20mgm1/Pickering, Firlands Road/Phase 2/AD1.1.2.1.2.2.2		
Drawing No. PC2 / MR / A3 / Planning / 01	Rev:	-

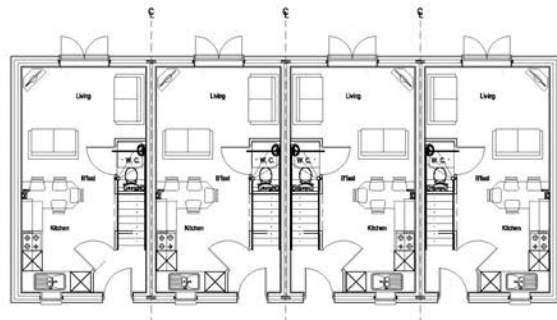

Ground Floor

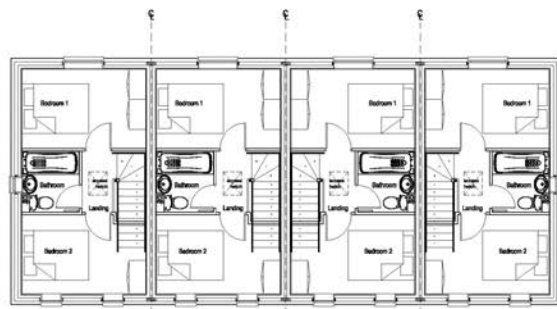


First Floor

Scale Bar: -
 1:100

THIS COPY HAD BEEN MADE BY OR WITH THE AUTHORITY OF RYEDALE DISTRICT COUNCIL PURSUANT TO SECTION 47 OF THE COPYRIGHT DESIGNS AND PATENTS ACT 1988. UNLESS THAT ACT PROVIDES A RELEVANT EXCEPTION TO COPYRIGHT, THE COPY MUST NOT BE COPIED WITHOUT THE PRIOR PERMISSION OF THE COPYRIGHT OWNER.

Revisions	
Development	
Firthlands Road Pickering Phase 2	
Drawing Title	
The Morden Housetype Planning Layouts 4 Block	
 Parsons Homes Yorkshire House Fulford York YO19 4BE Tel: 01904 842199 Fax: 01904 666142 www.parsonshomes.com	
Scale: 1:100 @ A3	Drawn: JBP
Date: Sept 17	
File: W20morden1/Pickering, Firthlands Road/Phase 2/A01.1.2.1.2.2.2	
Drawing No.	Rev
PC2 / MR / AS / Planning / 02	-

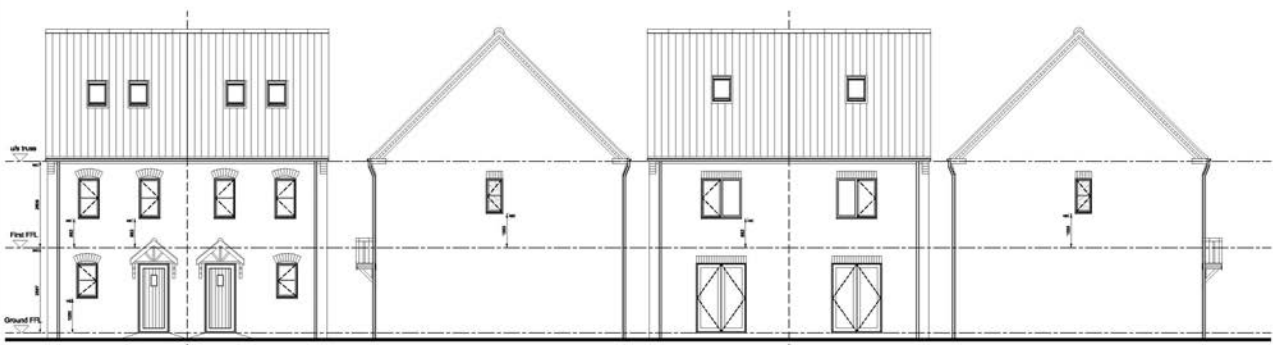


Front Elevation


Side Elevation

Rear Elevation


Side Elevation

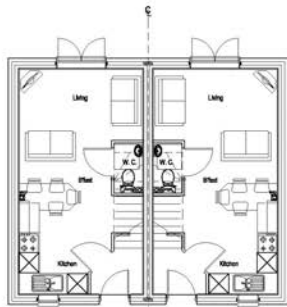

Ground Floor

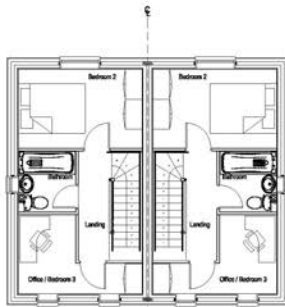

First Floor

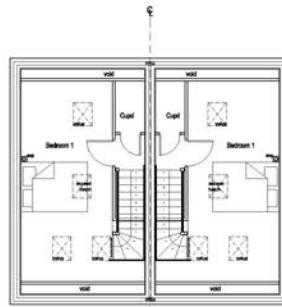


Second Floor

Scale Bar: -
 5m 1:100

THIS COPY HAD BEEN MADE BY OR WITH THE AUTHORITY OF RYEDALE DISTRICT COUNCIL PURSUANT TO SECTION 47 OF THE COPYRIGHT DESIGNS AND PATENTS ACT 1988. UNLESS THAT ACT PROVIDES A RELEVANT EXCEPTION TO COPYRIGHT, THE COPY MUST NOT BE COPIED WITHOUT THE PRIOR PERMISSION OF THE COPYRIGHT OWNER.

Revisions	
Development Firthlands Road Pickering Phase 2	
Drawing Title The Moseley Housetype Planning Drawing 2 Block	
 Parsimmon Homes Yorkshire House Fulford York YO19 4BE Tel: 01904 842199 Fax: 01904 556142 www.parsimmonhomes.com	
Scale: 1:100 @ A3	Drawn: JBP Date: Sept 17
File: M20mogen (Pickering, Firthlands Road) Phase 2 1-A01 1.2.1.12.2.2	
Drawing No. PC2 / M2 / 25 / Planning / 01	Rev: -

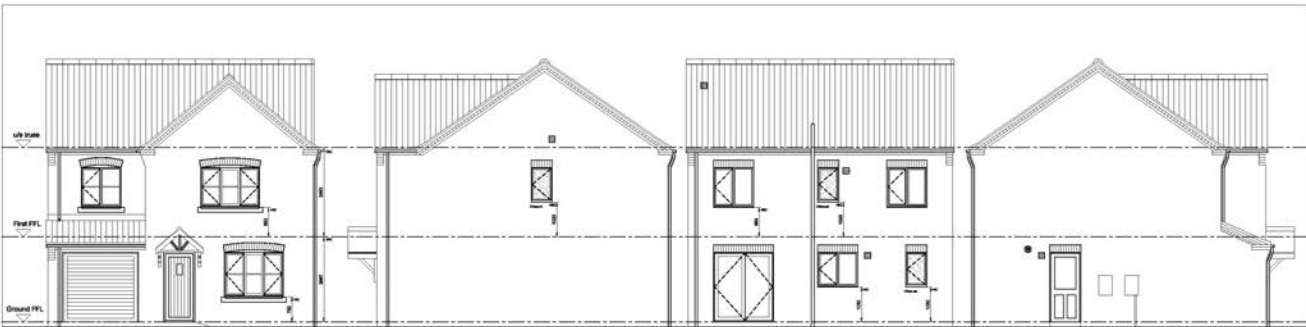

Front Elevation

Side Elevation

Rear Elevation

Side Elevation



Ground Floor



First Floor

Scale Bar: -

 5m 1:100

THIS COPY HAD BEEN MADE BY OR WITH THE AUTHORITY OF RYEDALE DISTRICT COUNCIL PURSUANT TO SECTION 47 OF THE COPYRIGHT DESIGNS AND PATENTS ACT 1988. UNLESS THAT ACT PROVIDES A RELEVANT EXCEPTION TO COPYRIGHT, THE COPY MUST NOT BE COPIED WITHOUT THE PRIOR PERMISSION OF THE COPYRIGHT OWNER.

Revisions	
Development Firthlands Road Pickering Phase 2	
Drawing Title The Roseberry Housetype Planning Elevations As Built	
 Parsons Homes Yorkshire Parsons House Fulford York YO3 4BE Tel: 01904 842199 Fax: 01904 566142 www.parsonshomes.com	
Scale: 1:100 @ A3	Drawn: JBP Date: Oct 2017
File: R20170101 Pickering, Firthlands Road 1, AP1 1, 2, 3, 2, 1, 2, 2, 3	
Drawing No: PIC2 / RO7 / AS / Planning / 01	Rev: -



Front Elevation

Side Elevation

Rear Elevation

Side Elevation




Ground Floor



First Floor

Scale Bar: -
5m 1:100

THIS COPY HAD BEEN MADE BY OR WITH THE AUTHORITY OF RYEDALE DISTRICT COUNCIL PURSUANT TO SECTION 47 OF THE COPYRIGHT DESIGNS AND PATENTS ACT 1988. UNLESS THAT ACT PROVIDES A RELEVANT EXCEPTION TO COPYRIGHT, THE COPY MUST NOT BE COPIED WITHOUT THE PRIOR PERMISSION OF THE COPYRIGHT OWNER.

Revisions			
Development Firthlands Road Pickering Phase 2			
Drawing Title The Roseberry Housetype Planning Elevations As Built			
 Perkinson Homes Yorkshire Perkinson House Fulford York YO21 4BE Tel: 01904 842199 Fax: 01904 866142 www.perkinsonhomes.com			
Scale:	1:100 @ A3	Drawn:	JBP
Date:	Oct 2017		
File:	R20170910/Pickering_Fulford_Rear1.A3/1.0/1.0/1.0/1.0/1.0/1.0		
Drawing No:	PK2 / RO / AS / Planning / 01	Rev:	-



Front Elevation

Side Elevation

Rear Elevation

Side Elevation



Ground Floor



First Floor

Scale Bar: -
 5m 1:100

THIS COPY HAD BEEN MADE BY OR WITH THE AUTHORITY OF RYEDALE DISTRICT COUNCIL PURSUANT TO SECTION 47 OF THE COPYRIGHT DESIGNS AND PATENTS ACT 1988. UNLESS THAT ACT PROVIDES A RELEVANT EXCEPTION TO COPYRIGHT, THE COPY MUST NOT BE COPIED WITHOUT THE PRIOR PERMISSION OF THE COPYRIGHT OWNER.

Revisions

Development
**Firthlands Road
 Pickering
 Phase 2**

Drawing Title
**The Roseberry Housetype
 Planning Elevations
 Op Built**



Parkinson Homes Yorkshire
 Parkinson House
 Fulford
 York
 YO10 4BE
 Tel: 01904 842199
 Fax: 01904 666142
 www.parkinsonhomes.com

Scale: 1:100 @ A3 Drawn: JBP Date: Oct 2017
 File: R20170101 Pickering, Firthlands Road 1, AP1, 1.0, 1.1, 1.2, 1.3, 1.4

Drawing No: PK2 / RO / OP / Planning / 01 Rev: -




Front Elevation


Side Elevation

Rear Elevation


Side Elevation

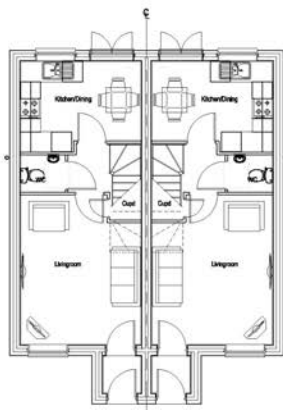

Ground Floor

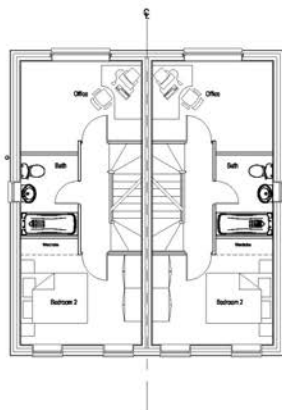

First Floor

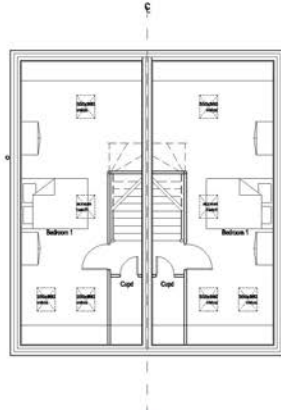

Second Floor



THIS COPY HAS BEEN MADE BY OR WITH THE AUTHORITY OF RYSDALE DISTRICT COUNCIL, PURSUANT TO SECTION 42 OF THE COPYRIGHT DESIGNS AND PATENTS ACT 1988. UNLESS THAT ACT PROVIDES A RELEVANT EXCEPTION TO COPYRIGHT, THE COPY MUST NOT BE COPIED WITHOUT THE PRIOR PERMISSION OF THE COPYRIGHT OWNER.

Revisions

Development
**Firthlands Road
 Pickering
 Phase 2**

Drawing Title
**The Sutton Housetype
 Planning Drawing
 2 Block**



Scale: 1:100 @ A3	Drawn: JBP	Date: Oct 2017
File: S:\Sutton\Pickering, Firthlands Road\A01.1.20.1.2.1.2.2.3		

Drawing No.: PNC/20/28/Planning/01	Rev: -
------------------------------------	--------



Front Elevation

Side Elevation




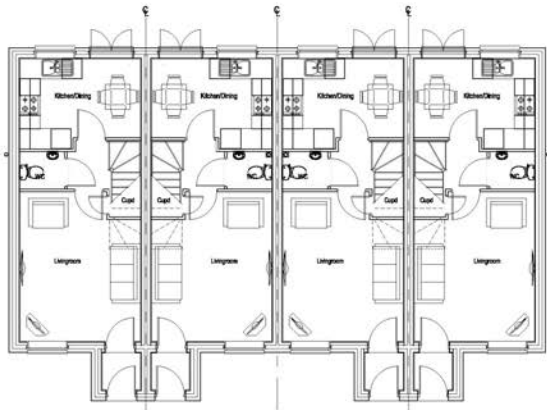
Rear Elevation

Side Elevation


Scale Bar: -
 5m 1:100

THIS COPY HAS BEEN MADE BY OR WITH THE AUTHORITY OF RYEDALE DISTRICT COUNCIL PURSUANT TO SECTION 47 OF THE COPYRIGHT DESIGNS AND PATENTS ACT 1988. UNLESS THAT ACT PROVIDES A RELEVANT EXCEPTION TO COPYRIGHT, THE COPY MUST NOT BE COPIED WITHOUT THE PRIOR PERMISSION OF THE COPYRIGHT OWNER.


Revisions	
Development Firthlands Road Pickering Phase 2	
Drawing Title The Sutton Housetype Planning Elevation 4 Block	
 Parsons Homes Yorkshire Parsons House Fulford York YO19 4RE Tel: 01904 642199 Fax: 01904 606142 www.parsonshomes.com	
Scale: 1:100 @ A3	Drawn: JSP Date: Oct 2017
File: E:\Users\j.pickering\Firthlands Road\1401123\1231233	
Drawing No: PC2 / SU / 4B / Planning / 01	Rev: -



Ground Floor

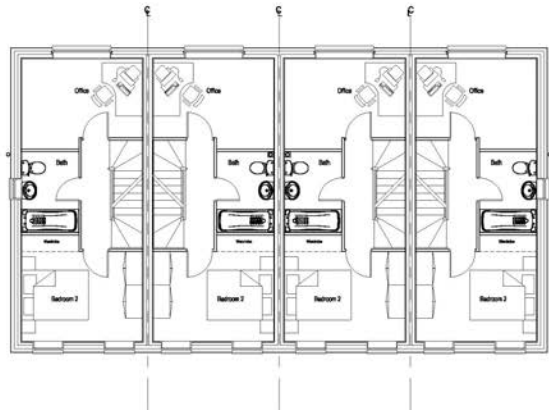


First Floor

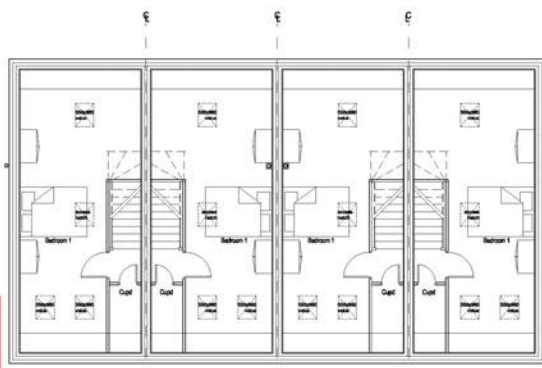

Second Floor

THIS COPY HAD BEEN MADE BY OR WITH THE AUTHORITY OF RYEDALE DISTRICT COUNCIL PURSUANT TO SECTION 47 OF THE COPYRIGHT DESIGNS AND PATENTS ACT 1988. UNLESS THAT ACT PROVIDES A RELEVANT EXCEPTION TO COPYRIGHT, THE COPY MUST NOT BE COPIED WITHOUT THE PRIOR PERMISSION OF THE COPYRIGHT OWNER.




Revisions		
Development Firthlands Road Pickering Phase 2		
Drawing Title The Sutton Housetype Planning Layouts 4 Block		
 Parsons Homes Yorkshire Parsons House Fulford York YO19 4BE Tel : 01904 642199 Fax : 01904 606142 www.parsonshomes.com		
Scale:	1:100 @ A3	Date: Oct 2017
Drawn:	JSP	
File: E:\Suttons 1 Pickering, Firthlands Road\A01.1.2.1.1.2.1.2.3		
Drawing No:	PC2 / SU / 4B / Planning / 01	Rev -



Front Elevation

Rear Elevation

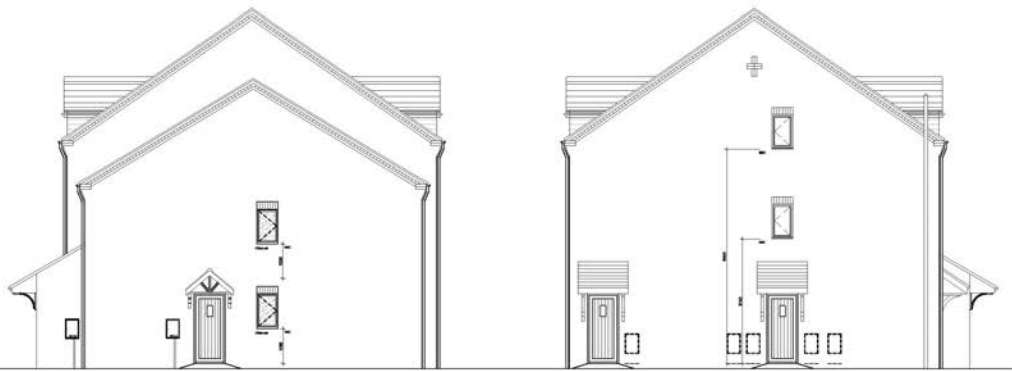


Side Elevation (Linton Side)

Side Elevation (Tri Maisonette Side)

Scale Bar: -

 5m 1:100

THIS COPY HAS BEEN MADE BY OR WITH THE AUTHORITY OF RYEDALE DISTRICT COUNCIL PURSUANT TO SECTION 47 OF THE COPYRIGHT DESIGNS AND PATENTS ACT 1988. UNLESS THAT ACT PROVIDES A RELEVANT EXCEPTION TO COPYRIGHT, THE COPY MUST NOT BE COPIED WITHOUT THE PRIOR PERMISSION OF THE COPYRIGHT OWNER.

Revisions	
Development Firthlands Road, Pickering Phase 2	
Drawing Title The Tri Maisonette & Linton Planning Elevation Plots 29 to 33	
 Parsimmon Homes Yorkshire Parsimmon House Fulford York YO15 4PE Tel: 01904 662769 Fax: 01904 668152 www.parsimmonhomes.com	
Scale: 1:100 @ A3	Drawn: JBP Date: Oct 2017
File: 888urmpm / Planning / Firthlands Road / A01 / 29 to 33.rvt	
Drawing No. PNC2 / TM-L1 / P29-33 / Planning / 01	Rev: -



Ground Floor Plan




First Floor Plan



Second Floor Plan

THIS COPY HAS BEEN MADE BY OR WITH THE AUTHORITY OF RYSDALE DISTRICT COUNCIL PURSUANT TO SECTION 47 OF THE COPYRIGHT DESIGNS AND PATENTS ACT 1988. UNLESS THAT ACT PROVIDES A RELEVANT EXCEPTION TO COPYRIGHT, THE COPY MUST NOT BE COPIED WITHOUT THE PRIOR PERMISSION OF THE COPYRIGHT OWNER.




Revisions		
Development Firthlands Road, Pickering Phase 2		
Drawing Title The Tri Maisonette & Linton Planning Layouts Plots 29 to 33		
 Parsimmon Homes Yorkshire Parsimmon House Fulford York YO15 4PE Tel: 01904 642169 Fax: 01904 658152 www.parsimmonhomes.com		
Scale: 1:100 @ A3	Drawn: JBP	Date: Oct 2017
File: 858urmap1/Pickering_Philwood Road/AD1/2/1/2/1/2.3.3		
Drawing No. PNC2/TM-L1/P29-33/Planning/102	Rev	-



Front Elevation

Rear Elevation

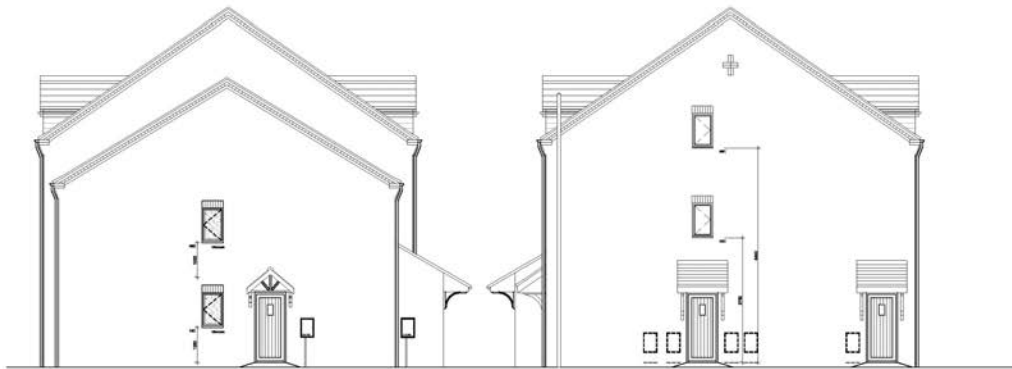


Side Elevation (Linton Side)

Side Elevation (Tri Maisonette Side)

Scale Bar: -

 5m 1:100

THIS COPY HAS BEEN MADE BY OR WITH THE AUTHORITY OF EYEDALE DISTRICT COUNCIL PURSUANT TO SECTION 47 OF THE COPYRIGHT DESIGNERS' AND PATENTS ACT 1988. UNLESS THAT ACT PROVIDES A RELEVANT EXCEPTION TO COPYRIGHT, THE COPY MUST NOT BE COPIED WITHOUT THE PRIOR PERMISSION OF THE COPYRIGHT OWNER.


Revisions			
Development			
Firthlands Road, Pickering Phase 2			
Drawing Title			
The Tri Maisonette & Linton Planning Elevation Plots 93 to 97			
		Parsimmon Homes Yorkshire Parsimmon House Fulford York YO15 4PE Tel: 01904 642169 Fax: 01904 668162 www.parsimmonhomes.com	
Scale:	1:100 @ A3	Drawn:	JBP
Date:	Oct 2017		
File:	88Linton (Planning, Firthlands Road) 1401.021.021.023		
Drawing No.	PH2 / TM.L1 / PH3-97 / Planning 01	Rev	-



Ground Floor Plan




First Floor Plan

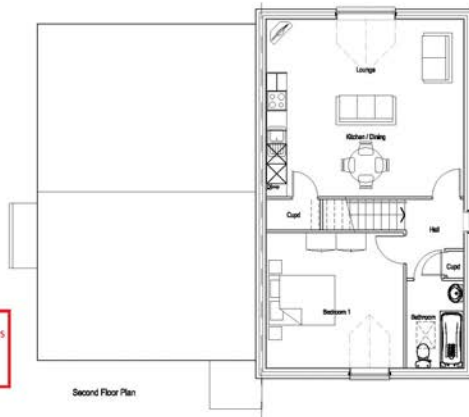


Second Floor Plan

THIS COPY HAD BEEN MADE BY OR WITH THE AUTHORITY OF RYEDALE DISTRICT COUNCIL PURSUANT TO SECTION 47 OF THE COPYRIGHT DESIGNS AND PATENTS ACT 1988. UNLESS THAT ACT PROVIDES A RELEVANT EXCEPTION TO COPYRIGHT, THE COPY MUST NOT BE COPIED WITHOUT THE PRIOR PERMISSION OF THE COPYRIGHT OWNER.



Revisions		
Development Firthlands Road, Pickering Phase 2		
Drawing Title The Tri Maisonette & Linton Planning Layouts Plots 93 to 97		
 Parsimmon Homes Yorkshire Parsimmon House Fulford York YO15 4PE Tel: 01904 662169 Fax: 01904 668162 www.parsimmonhomes.com		
Scale: 1:100 @ A3	Drawn: JBP	Date: Oct 2017
File: 858urgeson / Planning, Firthlands Road / A01 / 2.0 / 2.01.2.2.3		
Drawing No. PNC2 / TM-L1 / P93-97 / Planning / 02	Rev	-

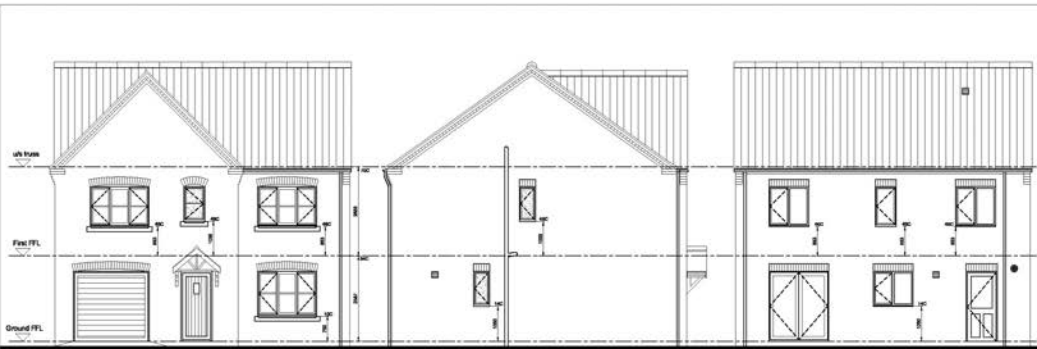

Front Elevation

Side Elevation


Rear Elevation



Ground Floor



First Floor

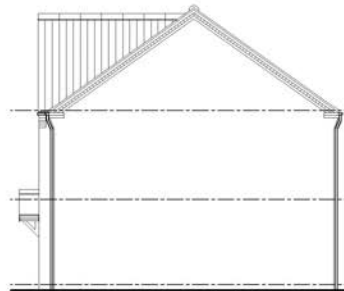

Side Elevation

THIS COPY HAD BEEN MADE BY OR WITH THE AUTHORITY OF RYEDALE DISTRICT COUNCIL PURSUANT TO SECTION 47 OF THE COPYRIGHT DESIGNS AND PATENTS ACT 1988. UNLESS THAT ACT PROVIDES A RELEVANT EXCEPTION TO COPYRIGHT, THE COPY MUST NOT BE COPIED WITHOUT THE PRIOR PERMISSION OF THE COPYRIGHT OWNER.

Revisions

Development
**Firthlands Road
 Pickering
 Phase 2**


Drawing Title
**The Winstar Housetype
 Planning Drawing
 As Built**



Parkinson Homes Yorkshire
 Parkinson House
 Fulford
 York
 YO10 4FE
 Tel : 01904 842199
 Fax : 01904 858142
 www.parkinsonhomes.com

Scale: 1:100 @ A3 Drawn: JGP Date: Oct 2017
 File: K:\0800001\Planning Pickering Road\1\PH11011211211212


Drawing No: PIC2 / W1 / AS / Planning 01 Rev: -

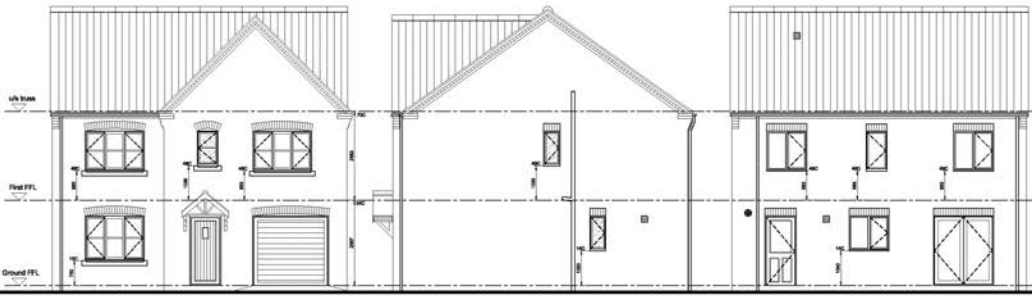

Front Elevation

Side Elevation


Rear Elevation

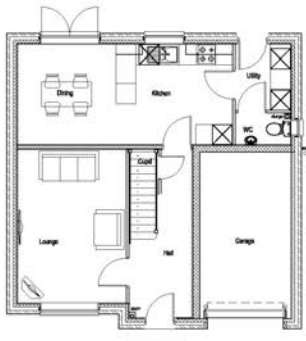

Ground Floor



First Floor

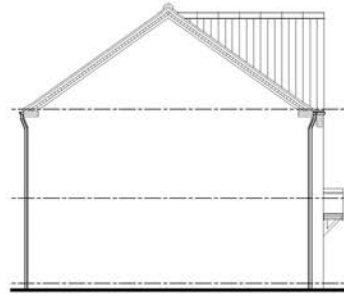

Side Elevation

THIS COPY HAD BEEN MADE BY OR WITH THE AUTHORITY OF RYEDALE DISTRICT COUNCIL PURSUANT TO SECTION 47 OF THE COPYRIGHT DESIGNS AND PATENTS ACT 1988. UNLESS THAT ACT PROVIDES A RELEVANT EXCEPTION TO COPYRIGHT, THE COPY MUST NOT BE COPIED WITHOUT THE PRIOR PERMISSION OF THE COPYRIGHT OWNER.

Revisions

Development
**Firthlands Road
 Pickering
 Phase 2**



Drawing Title
**The Winstar Housetype
 Planning Drawing
 Op Built**




Parkinson Homes Yorkshire
 Parkinson House
 Fulford
 York
 YO10 4FE
 Tel : 01904 842199
 Fax : 01904 668142
 www.parkinsonhomes.com

Scale: 1:100 @ A3 Drawn: JGP Date: Oct 2017
 File: K:\Drawings\Planning Pickering Road\AP11.02.12.1.02.0

Drawing No: PIC2 / W1 / OP / Planning / 01 Rev: -

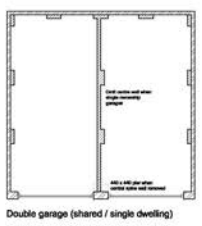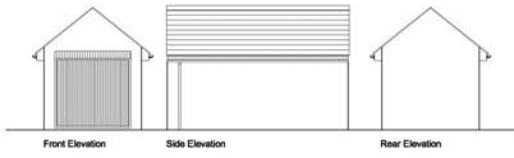

THIS COPY HAD BEEN MADE BY OR WITH THE AUTHORITY OF RYEDALE DISTRICT COUNCIL PURSUANT TO SECTION 47 OF THE COPYRIGHT DESIGNS AND PATENTS ACT 1988. UNLESS THAT ACT PROVIDES A RELEVANT EXCEPTION TO COPYRIGHT, THE COPY MUST NOT BE COPIED WITHOUT THE PRIOR PERMISSION OF THE COPYRIGHT OWNER.

Revision	
Development Firthlands Road, Pickering Phase 2	
Drawing Title Garages Types Planning Drawing	
 Perkinson Homes Yorkshire Perkinson House Fulford York YO18 4EE Tel: 01904 662700 Fax: 01904 661642 www.perkinsonhomes.com	
Scale: 1:100 @ A3	Drawn: JGP Date: Dec 2017
File: \\s:\projects\2017\Dec\Under App\Planning_Fulford\001\01\01\2017	
Drawing No: PCC / GA / Planning / 01	Rev: -