


External Elevation  
1:20

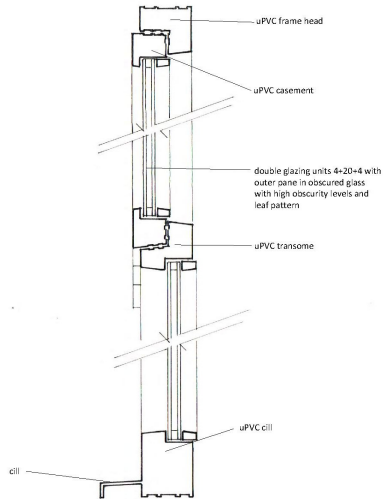

Section A:A  
1:50

THIS COPY HAS BEEN MADE BY OR WITH THE AUTHORITY OF RYEDALE DISTRICT COUNCIL PURSUANT TO SECTION 47 OF THE COPYRIGHT DESIGNS AND PATENTS ACT 1988. UNLESS THAT ACT PROVIDES A RELEVANT EXCEPTION TO COPYRIGHT, THE COPY MUST NOT BE COPIED WITHOUT THE PRIOR PERMISSION OF THE COPYRIGHT OWNER.

Date Valid 11/06/2019

revision	description	date

The contractor shall check all dimensions on site and report discrepancies before work commences.  
No dimension shall be scaled of this drawing.  
© Copyright of this drawing is retained by A.L. Turner

client	P. Hanson
project	Meadow House, Scrayingham, YO41 1JD
site	Bike Garage Dormer Window Detail

A.L. Turner + Associates	
1 LORING ROAD, RAVENSAR, SCARBOROUGH, YO13 8LY	01709 267307
atylturner20@btinternet.com	http://www.alturner.co.uk

date	scale	day	size	drawn
09/2019	1:5 1:20	A3	ALT	
note	as built			

drawing no.	rev
2365	13