


No. 02


FIRST FLOOR PLAN
AUGUST 2020
AS BUILT

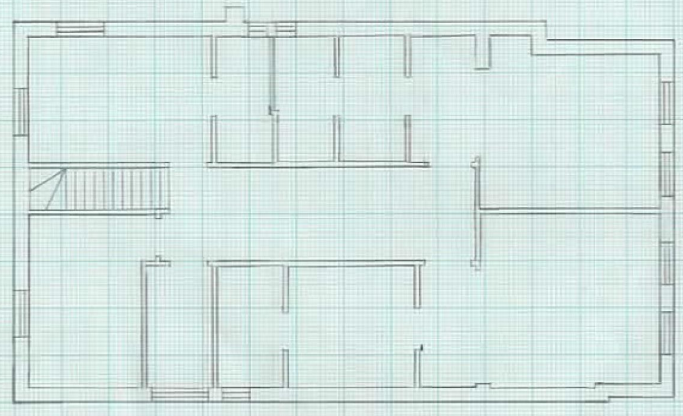

No. 03

FRONT ELEVATION
AUGUST 2020
AS BUILT

1m

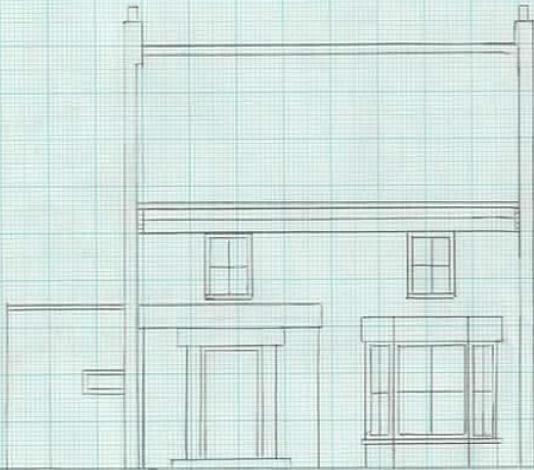

REAR ELEVATION




SKYLIGHTS 1.9m
ABOVE ATTIC
FLOOR LEVEL


No.06
GARDEN OFFICE

PLAN


1m

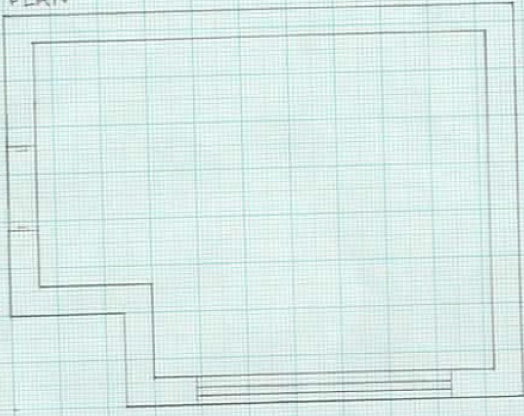

SOUTH ELEVATION

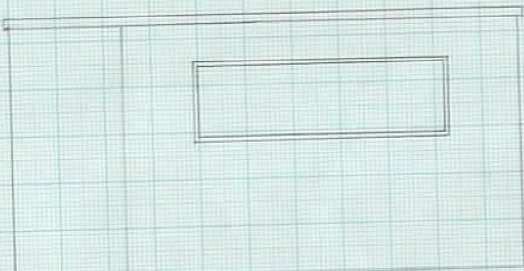


WEST ELEVATION

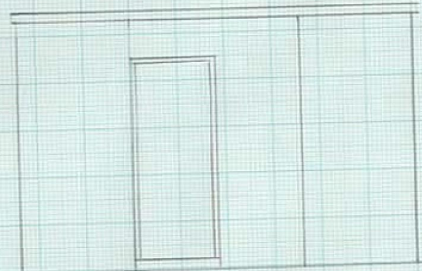

No 01

GROUND FLOOR PLAN
AUGUST 2020
AS BUILT

1m

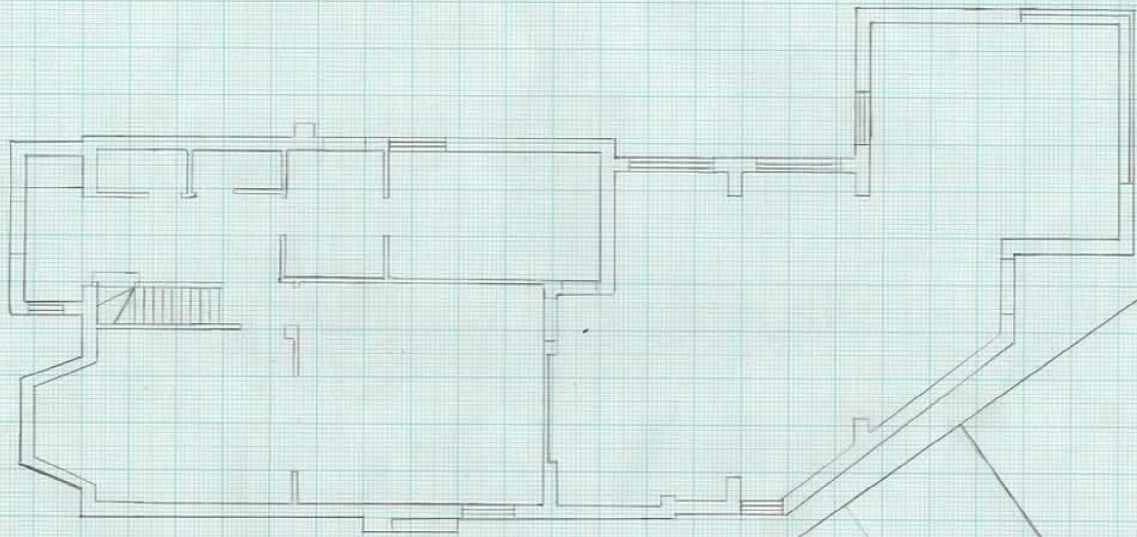


No. 05

NORTH ELEVATION
AUGUST 2020
AS BUILT



SKY LIGHTS
1.8M ABOVE
A-MG FLOOR

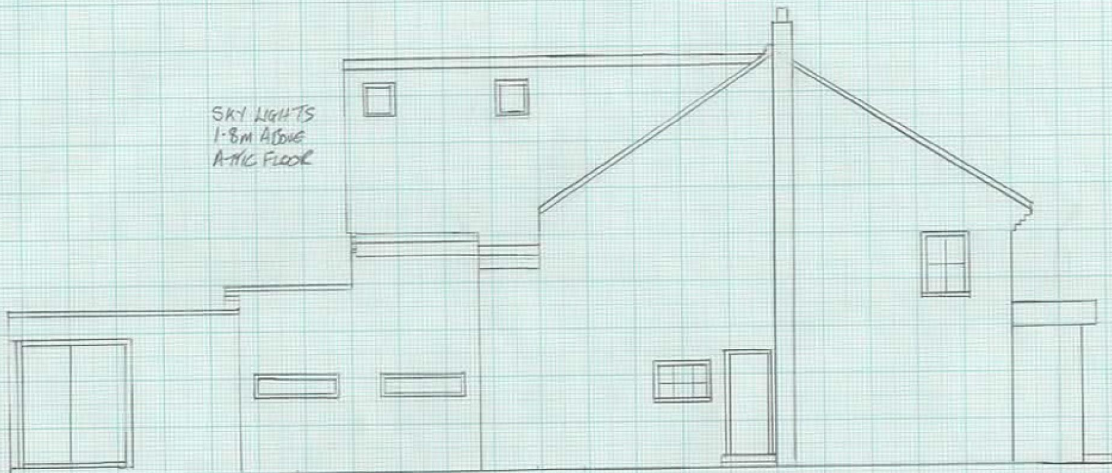

START

No. 04

SOUTH ELEVATION
AUGUST 2020
AS BUILT

