




North Elevation

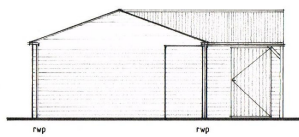


East Elevation

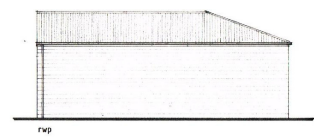

West Elevation

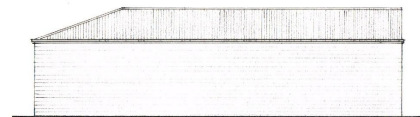

South Elevation

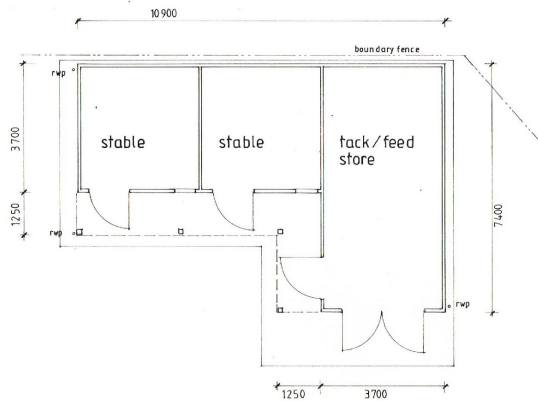

Plan

External Materials

Walls – horizontal stained and preserved timber boarding. Posts and brackets in 100x100mm stained timber.
Roof – 20° pitch covering in corrugated steel sheet in colour black.
Eaves – black PVC gutting.
Doors – vertical stained and preserved timber boarding with galvanised steel ironmongery.
Windows – obscured polycarbonate panels.

revision	description	date
----------	-------------	------

The contractor shall check all dimensions on site and report discrepancies before work commences.
 No dimension shall be scaled off this drawing.
 © Copyright of this drawing is retained by A.L. Turner

client	P. Hanson
project	Meadow House, Scrayingham, YO41 1JD
site	Stable Block as Built
A.L. Turner + Associates 1 LORING ROAD, RAVENSCAR, SCARBOROUGH, YO11 3EL 01795 397307 www.alturner.co.uk	

date	01/2018	scale	1:100	drawn	ALT
issue	as built	drawing no.	2365	rev.	10

Date Valid 24/01/2018

THIS COPY HAS BEEN MADE BY OR WITH THE AUTHORITY OF RYEDALE DISTRICT COUNCIL PURSUANT TO SECTION 47 OF THE COPYRIGHT DESIGNS AND PATENTS ACT 1988. UNLESS THAT ACT PROVIDES A RELEVANT EXCEPTION TO COPYRIGHT, THE COPY MUST NOT BE COPIED WITHOUT THE PRIOR PERMISSION OF THE COPYRIGHT OWNER.